

WALTHALL
 A 2027
 9-23-78

MISSISSIPPI
 BOARD OF WATER COMMISSIONERS
 416 North State Street
 Jackson, Mississippi 39201

WATER WELL DRILLERS LOG

Sept. 23 1978 Reynolds Walthall
 date well completed firm name county well located

LANDOWNER:
Willie Allard
Rt 3 Tylotown
 (mailing address)

description of formations encountered	from	to
<u>Red clay</u>	<u>0</u>	<u>20</u>
<u>Chalky sand</u>	<u>20</u>	<u>40</u>
<u>Red Chalk</u>	<u>40</u>	<u>63</u>
<u>Sand & gravel</u>	<u>63</u>	<u>72</u>

WELL LOCATION:
 sec. 29 T. 4 N. R. 10 E
1.2 miles N-W of Tylotown
 (distance) (direction) (nearest town)

WELL PURPOSE: Tractor
 (home, irrigation, municipal, industrial)

WELL COMPLETION DATA:
 (1) diameter (inches) _____
 (2) total depth (feet) 72
 (3) static water level (feet) 45 below above top of ground.
 (4) casing plastic bottom
 (material) (depth)
 _____ if telescope see back.
 (size)
 (5) screen 5' 69'
 (length) (depth to top)
4" plastic
 (size) (material)
 (6) pump by other
 (HP) (yield gpm)
West
 (type power)
 (7) electric log no
 (yes or no)

 (organization running log)

(8) how well bottom plugged
wooden plug


DRILLERS REMARKS:

RECEIVED
 ALL
 JAN 15 1978

MISS. BD. OF WATER COMM.

If well telescopes please sketch and show depths.

GROUND LEVEL

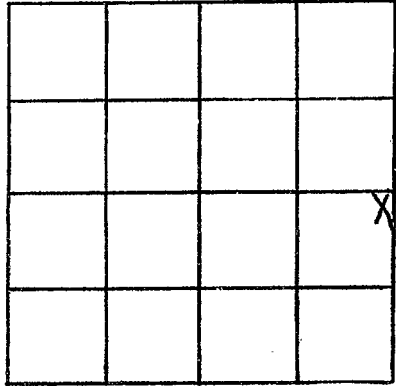

SECTION 29

Please indicate well location X.

ADDITIONAL INFORMATION

If more than one screen,
show locations of each on sketch.