

WALTHALL
 A 2031
 9-08-78

MISSISSIPPI
 BOARD OF WATER COMMISSIONERS
 416 North State Street
 Jackson, Mississippi 39201

well 10

WATER WELL DRILLERS LOG

Sept 8 1978 Reem well ser Walthall
 date well completed firm name county well located

LANDOWNER:
Tommy Whitt
Rt 3 Fyltowner
 (mailing address)

description of formations encountered	from	to
clay & gravel	0	22
well sand	22	68
lobbles & clay	68	115
gravel & sand	115	127

WELL LOCATION:
 sec 29 T 4 N R 10 E
12 miles N-NW of Fyltowner
 (distance) (direction) (nearest town)

WELL PURPOSE: dom
 (home, irrigation, municipal, industrial)

WELL COMPLETION DATA:

(1) diameter (inches) 4"

(2) total depth (feet) 127'

(3) static water level (feet) 77 below above top of ground.

(4) casing plastic bottom
 (material) (depth)

— if telescope see back.
 (size)

(5) screen 5' 122'
 (length) (depth to top)

1/2" plastic
 (size) (material)

(6) pump 1 sub. 20
 (HP) (yield gpm)

elect
 (type power)

(7) electric log no
 (yes or no)

—
 (organization running log)


(8) how well bottom plugged
wooden plug

DRILLERS REMARKS:
two well made
side by side

RECEIVED
 JAN 15 1978
 MISS. Bd. OF WATER COMMISSIONERS

If well telescopes please sketch and show depths.

GROUND LEVEL

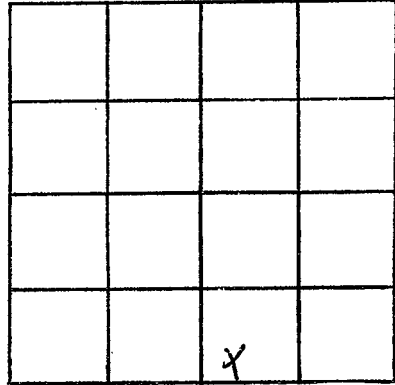

SECTION 20

Please indicate well location X.

ADDITIONAL INFORMATION

If more than one screen, show locations of each on sketch.