

Walsh
A 2032
00-16-73

MISSISSIPPI
 BOARD OF WATER COMMISSIONERS
 416 North State Street
 Jackson, Mississippi 39201

WATER WELL DRILLERS LOG

10-16
 date well completed

in 79 Fitzgerald Well Co
 firm name

Walsh
 county well located

LANDOWNER:
Huey Cantrell
RR. Jones ms.
 (mailing address)

description of formations encountered	from	to
<u>Red clay</u>	<u>0</u>	<u>20</u>
<u>Red sand</u>	<u>20</u>	<u>70</u>
<u>White clay</u>	<u>70</u>	<u>120</u>
<u>Coarse sand & gravel</u>	<u>120</u>	<u>141</u>

WELL LOCATION:
 sec. 5 T. 4 N. R. 10 E.
 S. W.
2 miles N of Enon
 (distance) (direction) (nearest town)

WELL PURPOSE: Home
 (home, irrigation, municipal, industrial)

- WELL COMPLETION DATA:
- (1) diameter (inches) 4
 - (2) total depth (feet) 149
 - (3) static water level (feet) 80 below/above top of ground.
 - (4) casing PVC 141
 (material) (depth)
4 if telescope see back.
 (size)
 - (5) screen 8 141
 (length) (depth to top)
4 PVC
 (size) (material)
 - (6) pump 1/2 10
 (HP) (yield gpm)
4 hp
 (type power)
 - (7) electric log no
 (yes or no)
 (organization running log)
 - (8) how well bottom plugged Sand fill

DRILLERS REMARKS:


DEPT. OF NATURAL RESOURCES
 BUREAU OF LAND & WATER RESOURCES

NOV - 7 1973

RECEIVED

If well telescopes please sketch and show depths.

GROUND LEVEL

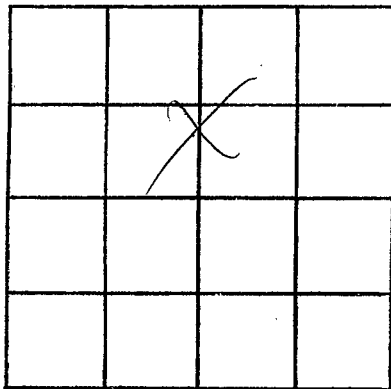

SECTION 5

Please indicate well location X.

ADDITIONAL INFORMATION

If more than one screen,
show locations of each on sketch.