

Walthall
R 2033
10-16-79

MISSISSIPPI
BOARD OF WATER COMMISSIONERS
416 North State Street
Jackson, Mississippi 39201

WATER WELL DRILLERS LOG

10-16 1979 F. General Bill Lewis Walthall
date well completed firm name county well located

LANDOWNER:
L. Roy Blackwell
P.R. Tylston
(mailing address)

description of formations encountered	from to	
<u>Red clay</u>	<u>0</u>	<u>20</u>
<u>Red sand</u>	<u>20</u>	<u>40</u>
<u>Red sand & gravel</u>	<u>40</u>	<u>100</u>
<u>Brown sand & gravel</u>	<u>100</u>	<u>115</u>

WELL LOCATION:
sec. 18 T. 4 N. R. 10 E.
8 miles SW of Tylston
(distance) (direction) (nearest town)

WELL PURPOSE: Home
(home, irrigation, municipal, industrial)


- WELL COMPLETION DATA:
- (1) diameter (inches) 4
 - (2) total depth (feet) 115
 - (3) static water level (feet) 55 below top of ground.
 - (4) casing PVC, 107
(material) (depth)
4 if telescope see back.
(size)
 - (5) screen 8, 107
(length) (depth to top)
4, PVC
(size) (material)
 - (6) pump 1/2, 10
(HP) (yield gpm)
Elu
(type power)
 - (7) electric log no
(yes or no)
(organization running log)
 - (8) how well bottom plugged Seal block

DRILLERS REMARKS:

DEPT. OF NATURAL RESOURCES
BUREAU OF LAND & WATER RESOURCES
NOV - 7 - 1979
RECEIVED

If well telescopes please sketch and show depths.

GROUND LEVEL

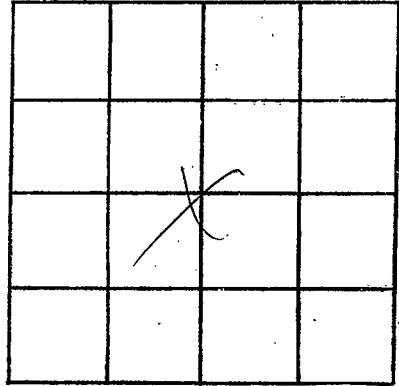

SECTION 18

Please indicate well location X.

ADDITIONAL INFORMATION

Multiple horizontal lines for recording additional information.

If more than one screen, show locations of each on sketch.