

Walthall
W 2034
 10-8-79

MISSISSIPPI
 BOARD OF WATER COMMISSIONERS
 416 North State Street
 Jackson, Mississippi 39201

WATER WELL DRILLERS LOG

10-3 1979 *Fitzgerald Well Serv* *Walthall*
 date well completed firm name county well located

LANDOWNER:
O.W. Sandifer
R.R. Joyers, Jr.
 (mailing address)

description of formations encountered	from	to
<i>Red clay</i>	<i>0</i>	<i>20</i>
<i>Red sand</i>	<i>20</i>	<i>100</i>
<i>Coarse sand & gravel</i>	<i>100</i>	<i>115</i>

WELL LOCATION:
 sec. *30* T. *4* N. R. *10* E.
3 miles *E* of *Pineblake*
 (distance) (direction) (nearest town)

WELL PURPOSE: *Home*
 (home, irrigation, municipal, industrial)

- WELL COMPLETION DATA:
- (1) diameter (inches) *4*
 - (2) total depth (feet) *115*
 - (3) static water level (feet) *90* below/above top of ground.
 - (4) casing *PVC*, *107*,
 (material) (depth)
4 if telescope see back.
 (size)
 - (5) screen *8*, *107*,
 (length) (depth to top)
4, *PVC*
 (size) (material)
 - (6) pump *1/2*, *10*
 (HP) (yield gpm)
elec
 (type power)
 - (7) electric log *no*
 (yes or no)
 (organization running log)
 - (8) how well bottom plugged *hard floor*


DRILLERS REMARKS:

DEPT. OF NATURAL RESOURCES
 BUREAU OF LAND & WATER RESOURCES

NOV - 7 1979
 RECEIVED

If well telescopes please sketch and show depths.

GROUND LEVEL

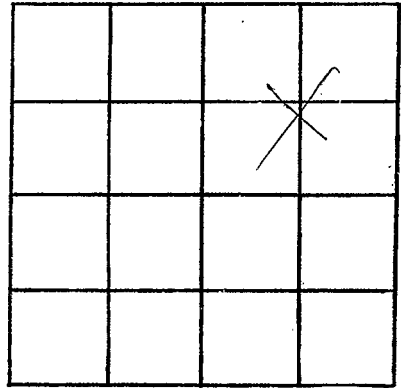

SECTION 30

Please indicate well location X.

ADDITIONAL INFORMATION

If more than one screen, show locations of each on sketch.