

Walthall  
A 2030  
8-2-79

MISSISSIPPI  
 BOARD OF WATER COMMISSIONERS  
 416 North State Street  
 Jackson, Mississippi 39201

WATER WELL DRILLERS LOG

8-2 1979  
 date well completed


Fitzgerald Drilling Walthall  
 firm name county well located

LANDOWNER:	description of formations encountered	from	to
<u>Heggie Barnett</u>			
<u>R.R. Johnson</u> (mailing address)	<u>White chalk</u>	<u>20</u>	<u>70</u>
WELL LOCATION:	<u>Red sand</u>	<u>70</u>	<u>95</u>
sec. <u>3</u> T. <u>4</u> N. R. <u>10</u> E	<u>Coarse sand &amp; gravel</u>	<u>95</u>	<u>110</u>
<u>6</u> miles <u>ENE</u> of <u>Green</u>			
(distance) (direction) (nearest town)			
WELL PURPOSE: <u>Home</u>			
(home, irrigation, municipal, industrial)			
WELL COMPLETION DATA:			
(1) diameter (inches) <u>4</u>			
(2) total depth (feet) <u>110</u>			
(3) static water level (feet) <u>75</u> below top of ground.			
(4) casing <u>PVC</u> , <u>102</u> (material) (depth)			
<u>4</u> if telescope see back. (size)			
(5) screen <u>8</u> , <u>102</u> (length) (depth to top)			
<u>4</u> , <u>PVC</u> (size) (material)			
(6) pump <u>1/2</u> , <u>10</u> (HP) (yield gpm)			
<u>Electric</u> (type power)			
(7) electric log <u>No</u> (yes or no)			
(organization running log)			
(8) how well bottom plugged <u>Sand &amp; gravel</u>			
DRILLERS REMARKS:			

Miss. Board of Water Comm.  
 SEP 12 1979  
 RECEIVED

If well telescopes please sketch and show depths.

GROUND LEVEL

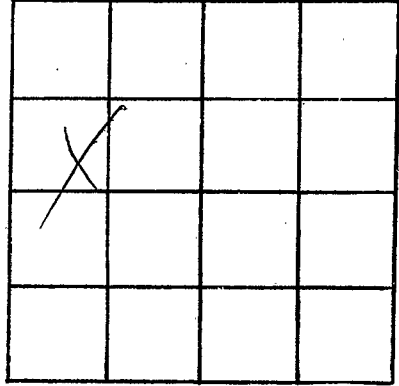

SECTION 13

Please indicate well location X.

ADDITIONAL INFORMATION

If more than one screen, show locations of each on sketch.