

WALTHALL

A 2037

6-26-79

MISSISSIPPI BOARD OF WATER COMMISSIONERS 416 North State Street Jackson, Mississippi 39201

WATER WELL DRILLERS LOG

6-26-79 date well completed

1979 Fitzgerald Well Dr firm name

Walthall county well located

LANDOWNER:

Rarely Phillips RR 1 Jayess (mailing address)

description of formations encountered

from to

Red Clay 0 20 Red sand 20 110 coarse sand & gravel 110 138

WELL LOCATION:

sec. 4 T 4 N R 10 E S W 4 miles S of Jayess (distance) (direction) (nearest town)

WELL PURPOSE: Home (home, irrigation, municipal, industrial)

WELL COMPLETION DATA:

- (1) diameter (inches) 4
(2) total depth (feet) 138
(3) static water level (feet) 80 below top of ground.
(4) casing PVC, 130 (material), (depth) 4 (size) if telescope see back.
(5) screen 8, 130 (length), (depth to top) 4, PVC (size), (material)
(6) pump 1/2, 10 (HP), (yield gpm) electric (type power)
(7) electric log no (yes or no) (organization running log)
(8) how well bottom plugged sand shell

Miss. Board of Water Comm.


AUG 3 1979

DRILLERS REMARKS:

RECEIVED

If well telescopes please sketch and show depths.

GROUND LEVEL

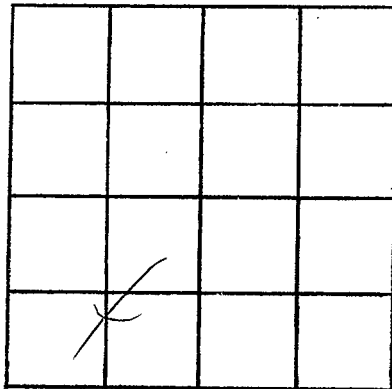

SECTION 4

Please indicate well location X.

ADDITIONAL INFORMATION

If more than one screen, show locations of each on sketch.