

WALTHALL

A 2038

7-6-79

MISSISSIPPI BOARD OF WATER COMMISSIONERS
416 North State Street
Jackson, Mississippi 39201

WATER WELL DRILLERS LOG

7-6 1979
date well completed

Fitzgerald Steel Inc
firm name

Walthall
county well located

LANDOWNER:

Lawson Davis Jr.

(mailing address)

WELL LOCATION:

sec. 7 T 4 N R 10 E
S W
3 miles N of Enon
(distance) (direction) (nearest town)

WELL PURPOSE: Home
(home, irrigation, municipal, industrial)

WELL COMPLETION DATA:

- (1) diameter (inches) 4
- (2) total depth (feet) 132
- (3) static water level (feet) 90 below top of ground.
- (4) casing PVC, 124 (material) (depth)
8 (size) if telescope see back.
- (5) screen 8, 124 (length) (depth to top)
4 (size) PVC (material)
- (6) pump 1/2, 10 (HP) (yield gpm)
Elec (type power)
- (7) electric log No (yes or no)
(organization running log)
- (8) how well bottom plugged lined

description of formations encountered

from to

Red Clay	0	20
Red Sand	20	115
Coarse sand & gravel	115	132

DRILLERS REMARKS:


Miss. Board of Water Comm.

AUG 3 1979

RECEIVED

If well telescopes please sketch and show depths.

GROUND LEVEL

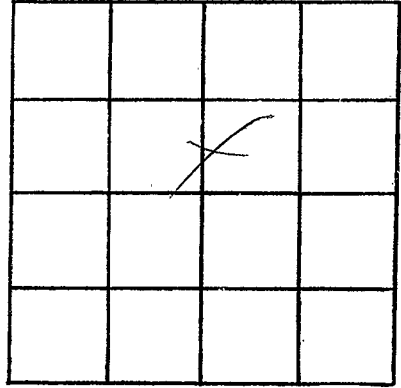

SECTION 2

Please indicate well location X.

ADDITIONAL INFORMATION

If more than one screen, show locations of each on sketch.