

WALTHALL

A 2039

11-14-79

MISSISSIPPI BOARD OF WATER COMMISSIONERS 416 North State Street Jackson, Mississippi 39201

WATER WELL DRILLERS LOG

11-14

date well completed

1979 Fitzgould well ser

firm name

Walthall

county well located

LANDOWNER:

Felicia Dunaway

R.R. Jones Mrs. (mailing address)

WELL LOCATION:

sec. 21 T. 4 N S R. 10 E W 2 miles E of Enon (distance) (direction) (nearest town)

WELL PURPOSE:

Home (home, irrigation, municipal, industrial)

WELL COMPLETION DATA:

- (1) diameter (inches) 4
(2) total depth (feet) 119
(3) static water level (feet) 55 below top of ground.
(4) casing PVC, 111 (material), (depth) 4 (size) If telescope see back.
(5) screen 8, 111 (length), (depth to top) 4, PVC (size), (material)
(6) pump 1/2 (HP), 10 (yield gpm)
(7) electric log yes (yes of no)
(8) how well bottom plugged Sand block

description of formations encountered

from to

Table with 3 columns: description of formations encountered, from, to. Rows include Red clay (0-20), Red sand (20-90), Red gravel (90-105), and Brown sand & gravel (105-119).

DRILLERS REMARKS:


DEPT. OF NATURAL RESOURCES BUREAU OF LAND & WATER RESOURCES

JAN 31 1980

RECEIVED

If well telescopes please sketch and show depths.

GROUND LEVEL

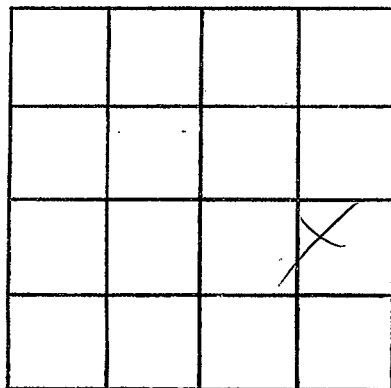

SECTION 21

Please indicate well location X.

ADDITIONAL INFORMATION

If more than one screen,
show locations of each on sketch.