

WALTHALL

A 3040

9-10-80

MISSISSIPPI BOARD OF WATER COMMISSIONERS  
416 North State Street  
Jackson, Mississippi 39201

WATER WELL DRILLERS LOG

Sept-10 1980 date well completed

Reeves Well Dr Walthall firm name

county well located

LANDOWNER:	description of formations encountered	from	to
ado. Brister Rt 3 Kytetown (mailing address)	sandy clay red sand	0 10	16 85
WELL LOCATION: sec. 30 T. 4 N R. 10 E 2 miles South of Enon (distance) (direction) (nearest town)	sand & gravel red chalk	85 110	110 115
WELL PURPOSE: home (home, irrigation, municipal, industrial)	sand & gravel	115	128
WELL COMPLETION DATA:			
(1) diameter (inches) 4"			
(2) total depth (feet) 128'			
(3) static water level (feet) 90' below top of ground.			
(4) casing <u>plastic</u> bottom (material) (depth)			
_____ if telescope see back. (size)			
(5) screen 5' 123' (length) (depth to top)			
4" plastic (size) (material)			
(6) pump <u>beathers</u> (HP) (yield gpm)			
<u>elect</u> (type power)			
(7) electric log <u>no</u> (yes or no)			
_____ (organization running log)			
(8) how well bottom plugged <u>backwash</u>			
DRILLERS REMARKS: <u>old well Bad</u>			


DEPT. OF NATURAL RESOURCES  
BUREAU OF LAND & WATER RESOURCES

MAY 14 1980

RECEIVED

If well telescopes please sketch and show depths.

GROUND LEVEL

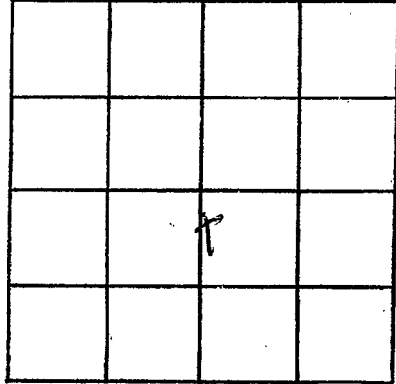

SECTION 30

Please indicate well location X.

ADDITIONAL INFORMATION

If more than one screen, show locations of each on sketch.