

Walshall  
A 2041  
7/14/80  
July 11

MISSISSIPPI  
 BOARD OF WATER COMMISSIONERS  
 416 North State Street  
 Jackson, Mississippi 39201

WATER WELL DRILLERS LOG

date well completed

firm name

county well located

1980 Reynolds & Sons Walshall

LANDOWNER:

Jerry Alexander  
Rt 0 Jayess  
 (mailing address)

description of formations encountered


from to

<u>clay</u>	<u>0</u>	<u>12</u>
<u>sand &amp; gravel</u>	<u>12</u>	<u>35</u>
<u>loess</u>	<u>35</u>	<u>60</u>
<u>sand &amp; gravel</u>	<u>60</u>	<u>80</u>

WELL LOCATION:

sec. 9 T. 4 N R. 10 E  
1/6 miles north of Jayess  
 (distance) (direction) (nearest town)

WELL PURPOSE: home  
 (home, irrigation, municipal, industrial)

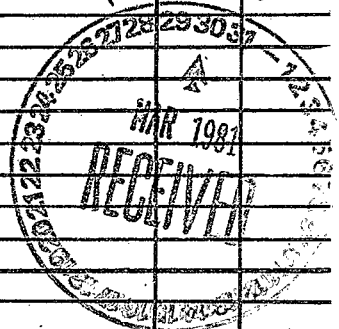

WELL COMPLETION DATA:


- (1) diameter (inches) 4"
- (2) total depth (feet) 80
- (3) static water level (feet) 27' below top of ground.
- (4) casing plastic bottom  
 (material) (depth)
- (size)        if telescope see back.
- (5) screen 5' 75'  
 (length) (depth to top)
- 4" plastic  
 (size) (material)
- (6) pump 3/4 10  
 (HP) (yield gpm)
- West  
 (type power)
- (7) electric log no  
 (yes or no)
- (organization running log)

(8) how well bottom plugged  
back wash

DRILLERS REMARKS:

If well telescopes please sketch and show depths.

GROUND LEVEL

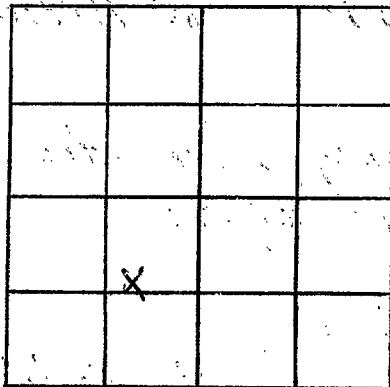

SECTION 9

Please indicate well location X.

ADDITIONAL INFORMATION

If more than one screen, show locations of each on sketch.