

Wellhall  
A 2043  
4-22-80

MISSISSIPPI  
 BOARD OF WATER COMMISSIONERS  
 416 North State Street  
 Jackson, Mississippi 39201

WATER WELL DRILLERS LOG

4-22- 1980 Fitzgerald Well Dr Wellhall  
 date well completed firm name county well located

LANDOWNER:

Billy Bayal

R.R. Jaynes, Jr.  
 (mailing address)

description of formations encountered

from to

<u>Red clay</u>	<u>0</u>	<u>20</u>
<u>Red sand</u>	<u>20</u>	<u>90</u>
<u>Coarse sand &amp; gravel</u>	<u>90</u>	<u>112</u>

WELL LOCATION:

sec. 26 T. 40 N. R. 10 E. S. 5  
5.1 miles SE of Evon  
 (distance) (direction) (nearest town)

WELL PURPOSE:

Home  
 (home, irrigation, municipal, industrial)

WELL COMPLETION DATA:

- diameter (inches) 4
- total depth (feet) 112
- static water level (feet) 85 below above top of ground.
- casing PVC, 104,  
 (material) (depth)  
4 if telescope see back.  
 (size)
- screen 8, 104  
 (length) (depth to top)  
4, PVC  
 (size) (material)
- pump 1/2, 60  
 (HP) (yield gpm)  
Elc  
 (type power)
- electric log no  
 (yes or no)  
 (organization running log)
- how well bottom plugged Sandblst

DEPT. OF NATURAL RESOURCES  
 BUREAU OF LAND & WATER RESOURCES


DRILLERS REMARKS:

JUN 20 1980

RECEIVED

If well telescopes please sketch and show depths.

GROUND LEVEL

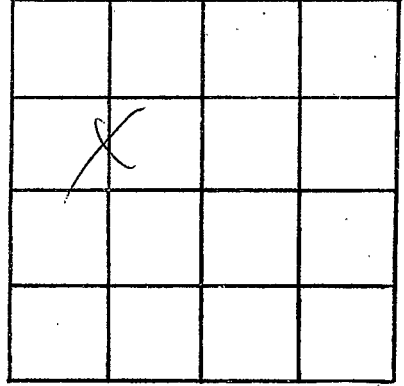

SECTION 26

Please indicate well location X.

ADDITIONAL INFORMATION

If more than one screen, show locations of each on sketch.