

Walshall

A 2044

4-9-80

MISSISSIPPI
 BOARD OF WATER COMMISSIONERS
 416 North State Street
 Jackson, Mississippi 39201

WATER WELL DRILLERS LOG

4-9 1980
 date well completed

Fitzgerald Steel Inc
 firm name

Walshall
 county well located

LANDOWNER:

Walter Magee
R.R. Jones, MS.
 (mailing address)

description of formations encountered

from to

<u>Red clay</u>	<u>0</u>	<u>20</u>
<u>Red sand & gravel</u>	<u>20</u>	<u>135</u>
<u>Coarse sand & gravel</u>	<u>135</u>	<u>165</u>

WELL LOCATION:

sec. 8 T. 4N S. R. 10E W.

2 miles N of Evon
 (distance) (direction) (nearest town)

WELL PURPOSE:

Home
 (home, irrigation, municipal, industrial)

WELL COMPLETION DATA:

- (1) diameter (inches) 4
- (2) total depth (feet) 165
- (3) static water level (feet) 115 below top of ground.
- (4) casing 10C, 147
 (material) (depth)
4 if telescope see back.
 (size)
- (5) screen 8, 147
 (length) (depth to top)
4, 10C
 (size) (material)
- (6) pump 1/2, 10
 (HP) (yield gpm)
glu
 (type power)
- (7) electric log DT
 (yes or no)
Walshall
 (organization running log)
- (8) how well bottom plugged Sandstone

DEPT. OF NATURAL RESOURCES
 BUREAU OF LAND & WATER RESOURCES


JUN 20 1980

RECEIVED

DRILLERS REMARKS:

If well telescopes please sketch and show depths.

GROUND LEVEL

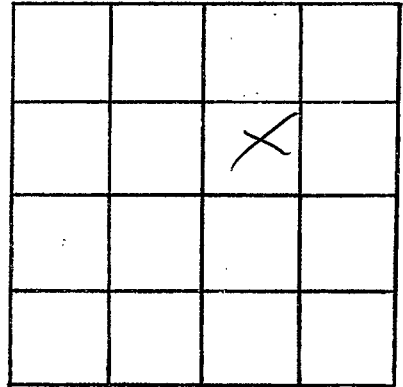

SECTION 8

Please indicate well location X.

ADDITIONAL INFORMATION

If more than one screen,
show locations of each on sketch.