

WATKINS
A 2045
2-26-80

MISSISSIPPI
BOARD OF WATER COMMISSIONERS
416 North State Street
Jackson, Mississippi 39201


WATER WELL DRILLERS LOG

2-26 1980 date well completed
Fitzgerald Well Drilling firm name
Wattall county well located

LANDOWNER:	description of formations encountered	from	to
Willie Rowell	Red Clay	0	20
R.R. Jones - (mailing address)	Red Sand	20	60
WELL LOCATION: sec. 10 T 4 N R 10 E S W 4 miles E of Enon (distance) (direction) (nearest town)	White Chalk	60	165
WELL PURPOSE: Home (home, irrigation, municipal, industrial)	Cane sand & gravel	165	180
WELL COMPLETION DATA:			
(1) diameter (inches) 4			
(2) total depth (feet) 180			
(3) static water level (feet) 80 below top of ground.			
(4) casing PVC, 172 (material) (depth)			
4 (size) If telescope see back.			
(5) screen 8, 172 (length) (depth to top)			
4 (size) PVC (material)			
(6) pump 1/2, 10 (HP) (yield gpm)			
Elec (type power)			
(7) electric log yes (yes or no)			
(organization running log)			
(8) how well bottom plugged Sand blk			
DRILLERS REMARKS:	DEPT. OF NATURAL RESOURCES BUREAU OF LAND & WATER RESOURCES MAR 25 1980 RECEIVED		

If well telescopes please sketch and show depths.

GROUND LEVEL

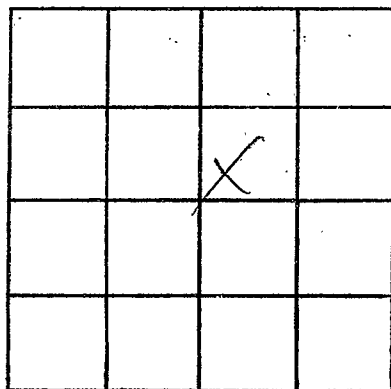

SECTION 10

Please indicate well location X.

ADDITIONAL INFORMATION

If more than one screen,
show locations of each on sketch.