

Walthall  
A 2046  
12-20-80

MISSISSIPPI  
 BOARD OF WATER COMMISSIONERS  
 416 North State Street  
 Jackson, Mississippi 39201

WATER WELL DRILLERS LOG

12-20 1980 Fitzgerald Well Serv Walthall  
 date well completed firm name county well located

LANDOWNER:	description of formations encountered	from	to
<u>Anthony LeJeune</u> <u>RR 2 Jones</u> (mailing address)	<u>Red Clay</u> <u>Red Sand</u> <u>Coarse sand &amp; gravel</u>	<u>0</u> <u>20</u> <u>130</u>	<u>20</u> <u>130</u> <u>145</u>
<b>WELL LOCATION:</b>			
sec <u>21</u> T <u>4</u> N R <u>10</u> E S W <u>2</u> miles <u>E</u> of <u>ENON</u> (distance) (direction) (nearest town)			
<b>WELL PURPOSE:</b> <u>None</u> (home, irrigation, municipal, industrial)			
<b>WELL COMPLETION DATA:</b>			
(1) diameter (inches) <u>4</u>			
(2) total depth (feet) <u>145</u>			
(3) static water level (feet) <u>80</u> below top of ground. above			
(4) casing <u>20C</u> , <u>137</u> , (material) (depth) <u>4</u> if telescope see back. (size)			
(5) screen <u>8</u> , <u>137</u> (length) (depth to top)			
(6) pump <u>4</u> , <u>20C</u> (size) (material)			
(6) pump <u>1/2</u> <u>10</u> (HP) (yield gpm)			
(7) electric log <u>Elu</u> (type power)			
(7) electric log <u>no</u> (yes or no)			
(8) how well bottom plugged <u>Sand block</u> (organization running log)			
(8) how well bottom plugged <u>Sand block</u>			
DRILLERS REMARKS:			


DEPT. OF NATURAL RESOURCES  
 BUREAU OF LAND & WATER RESOURCES

JAN 29 1981

RECEIVED

If well telescopes please sketch and show depths.

GROUND LEVEL

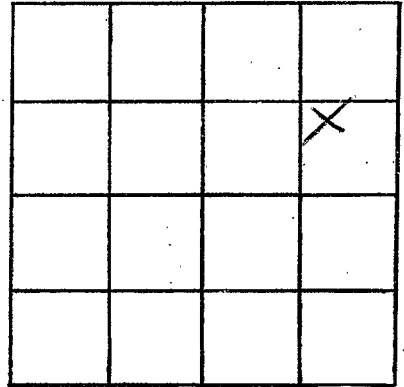

SECTION 21

Please indicate well location X.

ADDITIONAL INFORMATION

If more than one screen, show locations of each on sketch.