

WALTHALL
A 2057
10-10-81

MISSISSIPPI
BOARD OF WATER COMMISSIONERS
416 North State Street
Jackson, Mississippi 39201

WATER WELL DRILLERS LOG

10-10
date well completed

1981

Fitzwell Driller
firm name

Walthall
county well located

LANDOWNER:

Cherie Donaway

R.R. 1 Gayles ms.
(mailing address)

description of formations encountered

from to

Reef clay	0	20
Reef sand	20	70
Coarse sand & gravel	70	89

WELL LOCATION:

sec 24 T 4 N R 10 E
S W
3 miles E of Pucelle
(distance) (direction) (nearest town)

WELL PURPOSE:

Home
(home, irrigation, municipal, industrial)

WELL COMPLETION DATA:

- (1) diameter (inches) 4
- (2) total depth (feet) 89
- (3) static water level (feet) 61 below top of ground.
- (4) casing PVC, 81 (material) (depth)
4 (size) if telescope see back.
- (5) screen 8, 81 (length) (depth to top)
4 (size) PVC (material)
- (6) pump 1/2 (HP) 10 (yield gpm)
Electric (type power)
- (7) electric log yes (yes or no)
(organization running log)
- (8) how well bottom plugged Seal (Seal)

DRILLERS REMARKS:


DEPT. OF NATURAL RESOURCES
BUREAU OF LAND & WATER RESOURCES

NOV 20 1981

RECEIVED

If well telescopes please sketch and show depths.

GROUND LEVEL

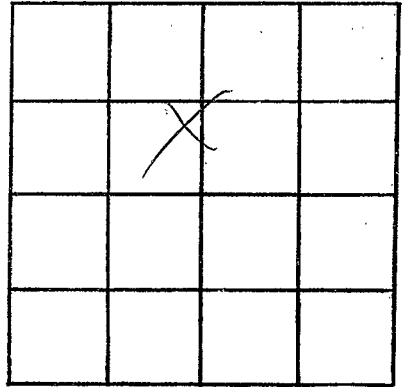

SECTION 24

Please indicate well location X.

ADDITIONAL INFORMATION

If more than one screen, show locations of each on sketch.