

WALTHALL  
 A 2048  
 9-21-81

MISSISSIPPI  
 BOARD OF WATER COMMISSIONERS  
 416 North State Street  
 Jackson, Mississippi 39201

WATER WELL DRILLERS LOG

9-21 1981 *Fitzgerald well* *Walthall*  
 date well completed firm name county well located

LANDOWNER:	description of formations encountered	from	to
<i>Beltom Mathis</i>			
<i>R.R. Jones</i> (mailing address)	<i>Red clay Red sand Gumbo sand &amp; gravel</i>	<i>0 20 110</i>	<i>20 110 132</i>
WELL LOCATION: sec. <i>24</i> T <i>4</i> N R <i>10</i> E S W <i>4</i> miles <i>E</i> of <i>Prichard</i> (distance) (direction) (nearest town)			
WELL PURPOSE: (home, irrigation, municipal, industrial)			
WELL COMPLETION DATA:			
(1) diameter (inches) <i>4</i>			
(2) total depth (feet) <i>132</i>			
(3) static water level (feet) <i>70</i> below top of ground.			
(4) casing <i>PVC</i> , <i>124</i> , (material) (depth)			
<i>4</i> if telescope see back. (size)			
(5) screen <i>8</i> , <i>124</i> (length) (depth to top)			
<i>4</i> , <i>PVC</i> (size) (material)			
(6) pump <i>1/2</i> , <i>10</i> (HP) (yield gpm)			
<i>etc</i> (type power)			
(7) electric log <input checked="" type="checkbox"/> (yes or no)			
(organization running log)			
(8) how well bottom plugged <i>full</i>			
DRILLERS REMARKS:			


DEPT. OF NATURAL RESOURCES  
 BUREAU OF LAND & WATER RESOURCES

SEP 30 1981

RECEIVED

If well telescopes please sketch and show depths.

GROUND LEVEL

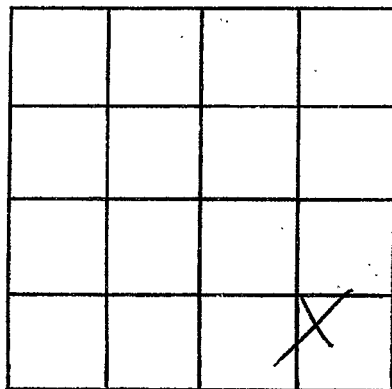

SECTION 2f

Please indicate well location X.

ADDITIONAL INFORMATION

If more than one screen,  
show locations of each on sketch.