

WALTHALL
A 2050
9-3-81

MISSISSIPPI
BOARD OF WATER COMMISSIONERS
416 North State Street
Jackson, Mississippi 39201

WATER WELL DRILLERS LOG

9-3 1981 *Fitzgerald Well Serv* *Walthall*
date well completed firm name county well located


LANDOWNER:	description of formations encountered	from	to
<i>Beverly Johnson</i>			
<i>R.R. 1 Jones</i> (mailing address)	<i>Red clay</i>	<i>0</i>	<i>20</i>
	<i>Red sand</i>	<i>20</i>	<i>90</i>
	<i>Coarse sand & gravel</i>	<i>90</i>	<i>100</i>
WELL LOCATION:			
sec. <i>8</i> T <i>4</i> N R <i>10</i> E S W			
<i>2</i> miles <i>N</i> of <i>ENON</i> (distance) (direction) (nearest town)			
WELL PURPOSE: <i>Home</i> (home, irrigation, municipal, industrial)			
WELL COMPLETION DATA:			
(1) diameter (inches) <i>4</i>			
(2) total depth (feet) <i>100</i>			
(3) static water level (feet) <i>70</i> below top of ground.			
(4) casing <i>PVC</i> <i>92</i> (material) (depth)			
<i>4</i> (size) if telescope see back.			
(5) screen <i>8</i> <i>92</i> (length) (depth to top)			
<i>4</i> <i>PVC</i> (size) (material)			
(6) pump <i>1/2</i> <i>10</i> (HP) (yield gpm)			
<i>Electric</i> (type power)			
(7) electric log <i>No</i> (yes or no)			
(organization running log)			
(8) how well bottom plugged <i>Sand plug</i>			
DRILLERS REMARKS:			

DEPT. OF NATURAL RESOURCES
BUREAU OF LAND & WATER RESOURCES

SEP 30 1981
RECEIVED

If well telescopes please sketch and show depths.

GROUND LEVEL

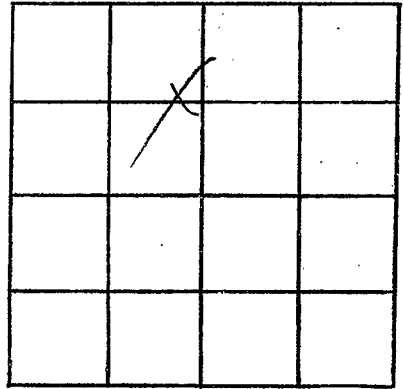

SECTION 8

Please indicate well location X.

ADDITIONAL INFORMATION

If more than one screen,
show locations of each on sketch.