

WALTHALL
A 2051
8-5-81

MISSISSIPPI
BOARD OF WATER COMMISSIONERS
416 North State Street
Jackson, Mississippi 39201

WATER WELL DRILLERS LOG

8-5
date well completed

1981 Filgural Creek Land
firm name


Walthall
county well located

| LANDOWNER: | description of formations encountered | from | to |
|---|---------------------------------------|----------------|------------------|
| Billy Bunch | | | |
| RR 3 Tyke town (mailing address) | Red clay Red Sand Green Sand | 0 20 110 | 20 110 120 |
| WELL LOCATION: | | | |
| sec. 26 T 4 N R 16 E S W | | | |
| 2 miles E of Do. Rife GRO (distance) (direction) (nearest town) | | | |
| WELL PURPOSE: Home (home, irrigation, municipal, industrial) | | | |
| WELL COMPLETION DATA: | | | |
| (1) diameter (inches) 4 | | | |
| (2) total depth (feet) 820 | | | |
| (3) static water level (feet) 80 below top of ground. | | | |
| (4) casing PVC, 112 (material), (depth), 4 (size) if telescope see back. | | | |
| (5) screen 8, 112 (length), (depth to top) 4, PVC (size), (material) | | | |
| (6) pump 1/2 (HP), 10 (yield gpm) Elev (type power) | | | |
| (7) electric log NO (yes or no) (organization running log) | | | |
| (8) how well bottom plugged Sand/Slit | | | |
| DRILLERS REMARKS: | | | |

MISSISSIPPI DEPT. OF NATURAL RESOURCES
BUREAU OF LAND & WATER RESOURCES
RECEIVED SEP 28 1981

If well telescopes please sketch and show depths.

GROUND LEVEL

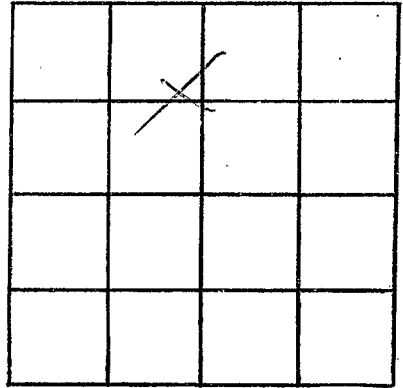

SECTION 26

Please indicate well location X.

ADDITIONAL INFORMATION

If more than one screen,
show locations of each on sketch.