

MISSISSIPPI DEPARTMENT OF NATURAL RESOURCES

Bureau of Land and Water Resources

Southport Mall

P.O. Box 10631


Jackson, Mississippi 39209

WATER WELL DRILLERS LOG

WALTHALL
A 2052
4-3-81


April 3 1981 Reuss Well Co Walthall
 date well completed firm name county well located

LANDOWNER:	description of formations encountered	from	to
<u>J. L. Carr</u>			
<u>Pt 3 Tyltoman</u> (mailing address)	<u>Red Clay</u>	<u>0</u>	<u>24</u>
	<u>Red sand</u>	<u>24</u>	<u>60</u>
	<u>hard big gravel</u>	<u>60</u>	<u>98</u>
	<u>blue clay</u>	<u>98</u>	<u>224</u>
	<u>sand / silt</u>	<u>224</u>	<u>225</u>
	<u>fine gravel & sand</u>	<u>225</u>	<u>249</u>
WELL LOCATION:			
sec <u>3</u> T <u>4</u> N R <u>10</u> E			
<u>3</u> miles <u>S-SE</u> of <u>Enon</u>			
(distance) (direction) (nearest town)			
WELL PURPOSE: <u>Home</u>			
(home, irrigation, municipal, industrial)			
WELL COMPLETION DATA:			
(1) diameter (inches) <u>4"</u>			
(2) total depth (feet) <u>249'</u>			
(3) static water level (feet) <u>110</u> below top of ground.			
(4) casing <u>plastic</u> <u>bottom</u>			
(material) (depth)			
<u>7</u> if telescope see back.			
(size)			
(5) screen <u>10"</u> <u>239'</u>			
(length) (depth to top)			
<u>4"</u> <u>plastic</u>			
(size) (material)			
(6) pump <u>3</u> <u>12</u>			
(HP) (yield gpm)			
<u>split</u>			
(type power)			
(7) electric log <u>no</u>			
(yes or no)			
<u>Walthall</u>			
(organization running log)			
(8) how well bottom plugged <u>Walthall</u>			
DRILLERS REMARKS:			

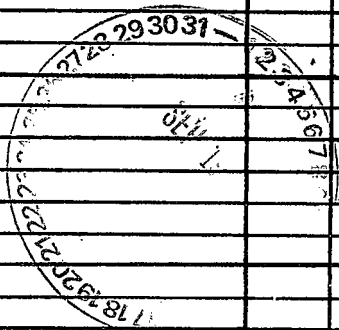

If well telescopes please sketch and show depths.

GROUND LEVEL

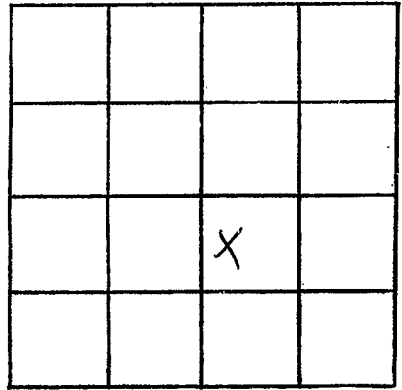

SECTION 36

Please indicate well location X.

ADDITIONAL INFORMATION

If more than one screen,
show locations of each on sketch.