


WALTHALL
A 2053
7-2-81

MISSISSIPPI
 BOARD OF WATER COMMISSIONERS
 416 North State Street
 Jackson, Mississippi 39201

WATER WELL DRILLERS LOG


7-2 1981 Fitzgerald Well Serv Walthall
 date well completed firm name county well located

LANDOWNER:	description of formations encountered	from	to
<u>Keith Howell</u>			
<u>RR. Jones</u> (mailing address)	<u>Red clay</u>	<u>0</u>	<u>20</u>
	<u>Red sand</u>	<u>20</u>	<u>60</u>
	<u>Coarse sand & gravel</u>	<u>60</u>	<u>75</u>
WELL LOCATION:			
sec. <u>13</u> T <u>4</u> N R <u>10</u> E S W			
<u>2</u> miles <u>E</u> of <u>Centers Creek</u> (distance) (direction) (nearest town)			
WELL PURPOSE: <u>Home</u> (home, irrigation, municipal, industrial)			
WELL COMPLETION DATA:			
(1) diameter (inches) <u>4</u>			
(2) total depth (feet) <u>75</u>			
(3) static water level (feet) <u>35</u> below top of ground. above			
(4) casing <u>PVC</u> , <u>67</u> , (material) (depth) <u>4</u> if telescope see back. (size)			
(5) screen <u>8</u> , <u>67</u> (length) (depth to top) <u>4</u> , <u>PVC</u> (size) (material)			
(6) pump <u>1/2</u> , <u>10</u> (HP) (yield gpm) <u>EL</u> (type power)			
(7) electric log <u>no</u> (yes or no) (organization running log)			
(8) how well bottom plugged <u>Seal OK</u>			
DRILLERS REMARKS:			

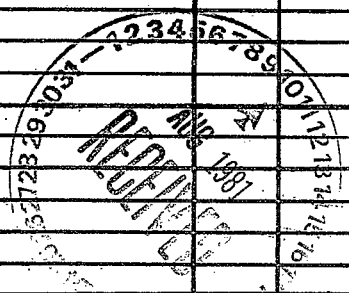

If well telescopes please sketch and show depths.

GROUND LEVEL

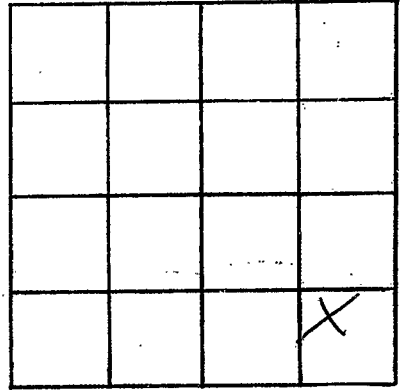

SECTION 13

Please indicate well location X.

ADDITIONAL INFORMATION

If more than one screen, show locations of each on sketch.