

MISSISSIPPI DEPARTMENT OF NATURAL RESOURCES

Bureau of Land and Water Resources

Southport Mall

P.O. Box 10631

Jackson, Mississippi 39209

WATER WELL DRILLERS LOG

Walthall  
A 2055  
1-2-81

~~1-2-81~~ 2 1981 Rever Miller Walthall  
date well completed firm name county well located

LANDOWNER:  
Kenneth Thompson  
Rt Lyle town  
(mailing address)

description of formations encountered	from	to
<u>Clay</u>	<u>0</u>	<u>16</u>
<u>Red sand</u>	<u>16</u>	<u>78</u>
<u>sand &amp; gravel</u>	<u>78</u>	<u>100</u>

WELL LOCATION:  
sec. 24 T 4 N R 10 E  
S  
4 miles east of Enon  
(distance) (direction) (nearest town)

WELL PURPOSE: home  
(home, irrigation, municipal, industrial)

WELL COMPLETION DATA:

(1) diameter (inches) 4"

(2) total depth (feet) 100

(3) static water level (feet) 70 below top of ground above

(4) casing plastic bottom  
(material) (depth)

       if telescope see back.  
(size)

(5) screen 5' 95'  
(length) (depth to top)

4" plastic  
(size) (material)

(6) pump 1/2 10  
(HP) (yield gpm)

electric  
(type power)

(7) electric log no  
(yes or no)

        
(organization running log)

(8) how well/bottom plugged  
Back wash & plug

DRILLERS REMARKS:  
✓


DEPT. OF NATURAL RESOURCES  
BUREAU OF LAND & WATER RESOURCES

JUL 27 1981

RECEIVED

If well telescopes please sketch and show depths.

GROUND LEVEL

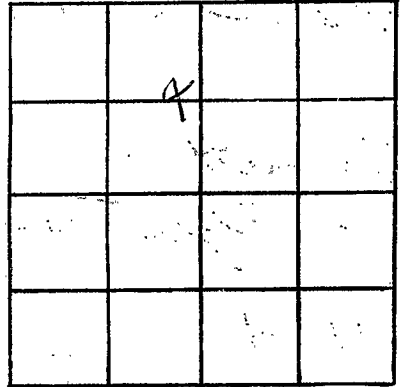

SECTION 24

Please indicate well location X.

ADDITIONAL INFORMATION

If more than one screen, show locations of each on sketch.