

Walsh  
A 2050  
5-14-81

MISSISSIPPI  
BOARD OF WATER COMMISSIONERS  
416 North State Street  
Jackson, Mississippi 39201

WATER WELL DRILLERS LOG

5-14  
date well completed

1981

General Well Ltd  
firm name

Walsh  
county well located

LANDOWNER:

Jack Parker

P.O. Box 10  
(mailing address)

WELL LOCATION:

sec. 21 T. 4 N R. 10 E  
S W  
3 miles ESE of ENON  
(distance) (direction) (nearest town)

WELL PURPOSE:

(home, irrigation, municipal, industrial)


WELL COMPLETION DATA:

- (1) diameter (inches) 4
- (2) total depth (feet) 103
- (3) static water level (feet) 60 below top of ground.
- (4) casing PVC 95 (material) (depth)  
4 (size) if telescope see back.
- (5) screen 8 95 (length) (depth to top)  
4 PVC (size) (material)
- (6) pump 1/2 10 (HP) (yield gpm)  
400 (type power)
- (7) electric log or (yes or no)  
(organization running log)
- (8) how well bottom plugged Solid

description of formations encountered

from to


Red clay	0	20
Red sand	20	90
Coarse sand & gravel	90	103

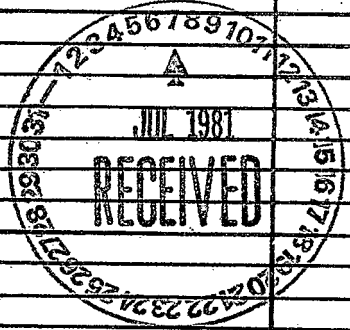

DRILLERS REMARKS:

If well telescopes please sketch and show depths.

GROUND LEVEL

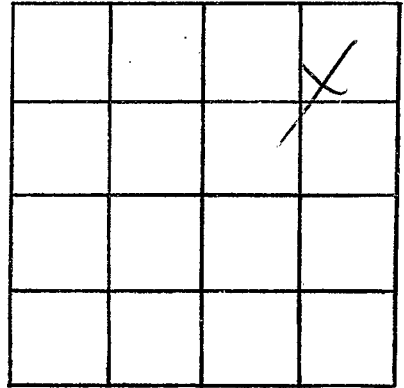

SECTION 21

Please indicate well location X.

ADDITIONAL INFORMATION

If more than one screen,  
show locations of each on sketch.