

MISSISSIPPI DEPARTMENT OF NATURAL RESOURCES

Bureau of Land and Water Resources

Southport, Mississippi

P.O. Box 10631

Jackson, Mississippi 39209

WATER WELL DRILLERS LOG

Walthall  
A2057

July 23 1981 Peewee Walthall Walthall  
date well completed firm name county well located

LANDOWNER:

R. J. Barber

Rt Tylotown

(mailing address)

description of formations encountered

from

to

<u>sandy clay</u>	<u>0</u>	<u>27</u>
<u>red sand</u>	<u>27</u>	<u>65</u>
<u>red chalk</u>	<u>65</u>	<u>72</u>
<u>yellow loamy sand</u>	<u>72</u>	<u>100</u>
<u>sand &amp; gravel</u>	<u>100</u>	<u>131</u>

WELL LOCATION:

sec 22 T 4 N R 10 E  
S

3 miles east of erton  
(distance) (direction) (nearest town)

WELL PURPOSE:

home  
(home, irrigation, municipal, industrial)

WELL COMPLETION DATA:

(1) diameter (inches) 4"  
(2) total depth (feet) 131

(3) static water level (feet) 90' below above top of ground.

(4) casing plastic bottom  
(material) (depth)

       if telescope see back.  
(size)

(5) screen 5' 126"  
(length) (depth to top)

4" plastic  
(size) (material)

(6) pump 1/2 hp 10'  
(HP) (yield gpm)

elec  
(type power)

(7) electric log no  
(yes or no)

        
(organization running log)

(8) how well bottom plugged backwash

DRILLERS REMARKS:


DEPT. OF NATURAL RESOURCES  
BUREAU OF LAND & WATER RESOURCES

FEB - 8 1982

RECEIVED

If well telescopes please sketch and show depths.

GROUND LEVEL

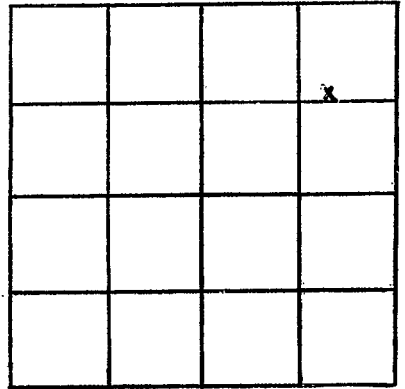

SECTION 22

Please indicate well location X.

ADDITIONAL INFORMATION

If more than one screen, show locations of each on sketch.