

Walthall
Asst

MISSISSIPPI
 BOARD OF WATER COMMISSIONERS
 416 North State Street
 Jackson, Mississippi 39201

WATER WELL DRILLERS LOG

6-29 1982 Fitzgerald L Walthall
 date well completed firm name county well located

LANDOWNER:	description of formations encountered	from	to
<u>Steve Coon</u>			
<u>RR - Jones, m.</u> (mailing address)	<u>Red Sand</u>	<u>20</u>	<u>100</u>
	<u>Coarse Sandstone</u>	<u>100</u>	<u>120</u>

WELL LOCATION:
 sec. 7 T. 4 N R. 10 E
 S W
1 miles N of ENON
 (distance) (direction) (nearest town)

WELL PURPOSE: H₂O
 (home, irrigation, municipal, industrial)

- WELL COMPLETION DATA:
- (1) diameter (inches) 4
 - (2) total depth (feet) 120
 - (3) static water level (feet) 85 below above top of ground.
 - (4) casing PR, 112,
 (material) (depth)
4 if telescope see back.
 (size)
 - (5) screen 8, 112
 (length) (depth to top)
4, PR
 (size) (material)
 - (6) pump 1/2 10
 (HP) (yield gpm)
ela
 (type power)
 - (7) electric log no
 (yes or no)
 (organization running log)
 - (8) how well bottom plugged Sub

DRILLERS REMARKS:


DEPT. OF NATURAL RESOURCES
 BUREAU OF LAND & WATER RESOURCES

JUL - 7 1982

RECEIVED

If well telescopes please sketch and show depths.

GROUND LEVEL

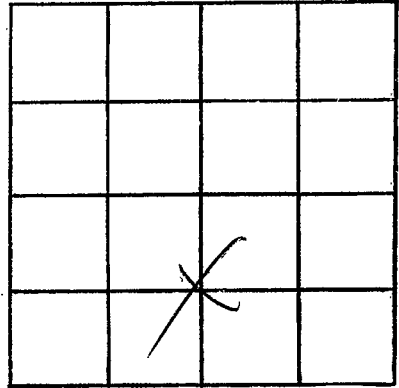

SECTION 2

Please indicate well location X.

ADDITIONAL INFORMATION

If more than one screen, show locations of each on sketch.