

Walthall
 A
 2000

MISSISSIPPI
 BOARD OF WATER COMMISSIONERS
 416 North State Street
 Jackson, Mississippi 39201

WATER WELL DRILLERS LOG

8-3 19 83 F. Howard well Inc Walthall
 date well completed firm name county well located

LANDOWNER:	description of formations encountered	from	to
Gene Sheets Express RR- 7 in ms. (mailing address)	Red clay Red sand Coarse sand & gravel	0 20 149	20 149 159
WELL LOCATION:			
sec. 21 T. 4 N R. 10 E S 2 miles E of Enon (distance) (direction) (nearest town)			
WELL PURPOSE: Home (home, irrigation, municipal, industrial)			
WELL COMPLETION DATA:			
(1) diameter (inches) 4			
(2) total depth (feet) 159			
(3) static water level (feet) 60 below top of ground.			
(4) casing PVC, 151, (material) (depth) 4 (size) if telescope see back.			
(5) screen 8, 151 (length) (depth to top)			
(6) pump 1/2, 10 (HP) (yield gpm) Elmer (type power)			
(7) electric log Yes (yes or no)			
(8) how well bottom plugged Sand			
DRILLERS REMARKS:			


DEPT. OF NATURAL RESOURCES
 BUREAU OF LAND & WATER RESOURCES

AUG 15 1983

RECEIVED

If well telescopes please sketch and show depths.

GROUND LEVEL

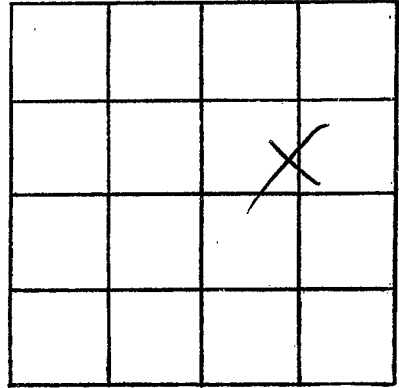

SECTION 21

Please indicate well location X.

ADDITIONAL INFORMATION

If more than one screen, show locations of each on sketch.