

MISSISSIPPI DEPARTMENT OF NATURAL RESOURCES

Bureau of Land and Water Resources

Southport Mall

P.O. Box 10631

Jackson, Mississippi 39209

WATER WELL DRILLERS LOG

Walthell
A 20062

11-13
date well completed

1984 Fitzgerald Well Serv
firm name

Walthell
county well located

LANDOWNER:
Ray Barot
R.R. James, ms.
(mailing address)

description of formations encountered	from	to
<u>Reel Clay</u>	<u>0</u>	<u>20</u>
<u>Reel Sand</u>	<u>20</u>	<u>60</u>
<u>Coarse sandstone</u>	<u>60</u>	<u>89</u>

WELL LOCATION:
sec. 33 T 4 N R 10 E
S W
3 miles S of EMM
(distance) (direction) (nearest town)

WELL PURPOSE:
Home
(home, irrigation, municipal, industrial)

- WELL COMPLETION DATA:
- (1) diameter (inches) 4
 - (2) total depth (feet) 89
 - (3) static water level (feet) 50 below above top of ground.
 - (4) casing pvc 81
(material) (depth)
4 if telescope see back.
(size)
 - (5) screen 8 81
(length) (depth to top)
4 pvc
(size) (material)
 - (6) pump 1/2 10
(HP) (yield gpm)
Electric
(type power)
 - (7) electric log Yes
(yes or no)
(organization running log)
 - (8) how well bottom plugged Sealed

DRILLERS REMARKS:


DEPT. OF NATURAL RESOURCES
BUREAU OF LAND & WATER RESOURCES

DEC - 6 1984

RECEIVED

If well telescopes please sketch and show depths.

GROUND LEVEL

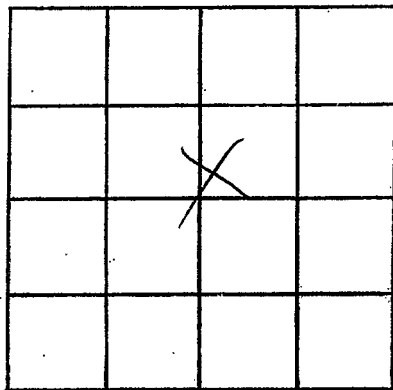

SECTION 33

Please indicate well location X.

ADDITIONAL INFORMATION

If more than one screen,
show locations of each on sketch.