

MISSISSIPPI DEPARTMENT OF NATURAL RESOURCES

Bureau of Land and Water Resources

Southport Mall

P.O. Box 10631

Jackson, Mississippi 39209

WATER WELL DRILLERS LOG

Walthall
A2003

7-13
date well completed

1984 Fitzgerald Well Serv Walthall
firm name county well located


LANDOWNER:	description of formations encountered	from	to
<u>Larry Smith</u> <u>Rt 1, Jones</u> (mailing address)	<u>Red clay</u> <u>Red sand</u> <u>Coarse sand & gravel</u>	<u>0</u> <u>20</u> <u>80</u>	<u>20</u> <u>80</u> <u>96</u>
<p>WELL LOCATION:</p> <p>sec. <u>33</u> T. <u>4</u> N. R. <u>10</u> E. S. W.</p> <p><u>3</u> miles <u>S</u> of <u>ELDON</u> (distance) (direction) (nearest town)</p>			
<p>WELL PURPOSE: <u>Home</u> (home, irrigation, municipal, industrial)</p>			
<p>WELL COMPLETION DATA:</p> <p>(1) diameter (inches) <u>4</u></p> <p>(2) total depth (feet) <u>96</u></p> <p>(3) static water level (feet) <u>45</u> below/above top of ground.</p> <p>(4) casing <u>PVC</u>, <u>88</u> (material) (depth)</p> <p><u>4</u> if telescope see back. (size)</p> <p>(5) screen <u>8</u>, <u>88</u> (length) (depth to top)</p> <p><u>4</u>, <u>PVC</u> (size) (material)</p> <p>(6) pump <u>1/2</u>, <u>10</u> (HP) (yield gpm)</p> <p><u>Electric</u> (type power)</p> <p>(7) electric log <u>Yes</u> (yes or no)</p> <p>(organization running log)</p> <p>(8) how well bottom plugged <u>Lead shot</u></p>			
<p>DRILLERS REMARKS:</p>			

DEPT. OF NATURAL RESOURCES
BUREAU OF LAND & WATER

AUG 23 1984
RECEIVED

If well telescopes please sketch and show depths.

GROUND LEVEL

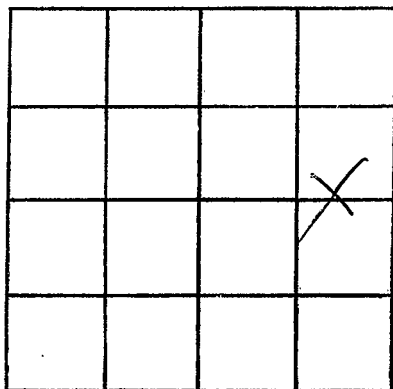

SECTION 33

Please indicate well location X.

ADDITIONAL INFORMATION

If more than one screen,
show locations of each on sketch.