

MISSISSIPPI DEPARTMENT OF NATURAL RESOURCES

Bureau of Land and Water Resources

Southport Mall

P.O. Box 10631

Jackson, Mississippi 39209

WATER WELL DRILLERS LOG

WALTHALL

WALTHALL
A 2064

12-4 date well completed

1985 Fitzgerald well Service firm name

Pike county well located

LANDOWNER: Dave Polcy
P.O. 1, Jackson, MS (mailing address)

description of formations encountered	from	to
Red clay	0	20
Red sand	20	90
Coarse sand & gravel	90	135

WELL LOCATION: sec. 18 T. 4 N R. 10 E W
1/2 miles W of Enola (distance) (direction) (nearest town)

WELL PURPOSE: Home (home, irrigation, municipal, industrial)

- WELL COMPLETION DATA:
- (1) diameter (inches) 4
 - (2) total depth (feet) 135
 - (3) static water level (feet) 90 below top of ground.
 - (4) casing PVC, 125 (material), (depth)
4 (size) if telescope see back.
 - (5) screen 10 (length), 125 (depth to top)
4 (size), PVC (material)
 - (6) pump 3/4 (HP), 15 (yield gpm)
Electric (type power)
 - (7) electric log Yes (yes or no)
(organization running log)
 - (8) how well bottom plugged

RECEIVED


DEC 30 1985

DEPARTMENT OF NATURAL RESOURCES
BUREAU OF LAND AND WATER RESOURCES

DRILLERS REMARKS:

If well telescopes please sketch and show depths.

GROUND LEVEL

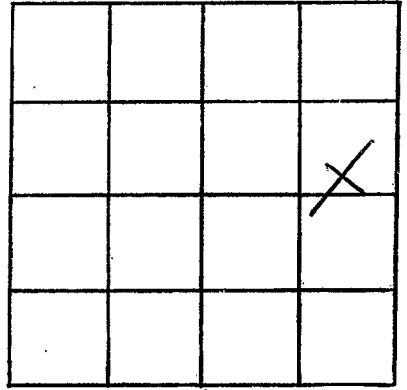

SECTION 18

Please indicate well location X.

ADDITIONAL INFORMATION

A series of horizontal lines for entering additional information, starting below the 'ADDITIONAL INFORMATION' header and extending to the bottom of the page.

If more than one screen, show locations of each on sketch.