

WALTHAM
A 22000

MISSISSIPPI DEPARTMENT OF NATURAL RESOURCES

Bureau of Land and Water Resources

Southport Mall

P.O. Box 10631

Jackson, Mississippi 39209

WATER WELL DRILLERS LOG

10-3
date well completed

1986

firm name

county well located

Flgenelwell Sew C. McCall

LANDOWNER:	description of formations encountered	from	to
Phillip Coon	Red clay	0	20
P.R. Jensen, Jr. (mailing address)	Red sand Coarse sand & gravel	20 145	149 159
WELL LOCATION:			
sec. 12 T 4 N R 10 E S W 3 miles E of Pinedale (distance) (direction) (nearest town)			
WELL PURPOSE: (home, irrigation, municipal, industrial)			
WELL COMPLETION DATA:			
(1) diameter (inches) 4			
(2) total depth (feet) 159			
(3) static water level (feet) 85 below top of ground.			
(4) casing PVC, 149 (material), (depth) 4 (size) if telescope see back.			
(5) screen 10 (length), 149 (depth to top) 4 (size), PVC (material)			
(6) pump 1/2 (HP), 10 (yield gpm) Elex (type power)			
(7) electric log Yes (yes or no) (organization running log)			
(8) how well bottom plugged Seal Mk			
DRILLERS REMARKS:			


RECEIVED

OCT 14 1986

Department of Natural Resources
Bureau of Land & Water Resources

If well telescopes please sketch and show depths.

GROUND LEVEL

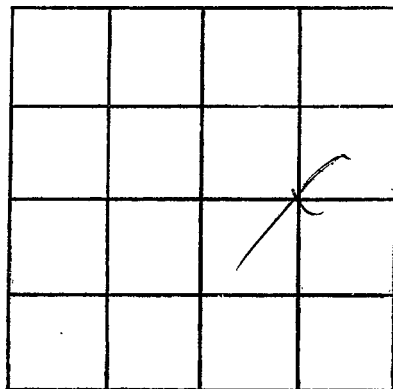

SECTION 12

Please indicate well location X.

ADDITIONAL INFORMATION

If more than one screen,
show locations of each on sketch.