

MISSISSIPPI DEPARTMENT OF NATURAL RESOURCES

Bureau of Land and Water Resources

Southport Mall

P.O. Box 10631


Jackson, Mississippi 39209

WATER WELL DRILLERS LOG

WALTHALL
A 2007

8-15 1986 F. S. Walthall & Son Walthall
date well completed firm name county well located

LANDOWNER:	description of formations encountered	from	to
M.C. Davis			
R.B. Whitman, Jr. (mailing address)	Red sand	20	85
	Coarse sand & gravel	85	100
WELL LOCATION:			
sec. 18 T. 4 N. R. 10 E S W			
3 miles NE of Salem (distance) (direction) (nearest town)			
WELL PURPOSE:			
Home (home, irrigation, municipal, industrial)			
WELL COMPLETION DATA:			
(1) diameter (inches) 4			
(2) total depth (feet) 100			
(3) static water level (feet) 70 below above top of ground.			
(4) casing PVC 90 (material) (depth)			
4 (size) if telescope see back.			
(5) screen 10 90 (length) (depth to top)			
4 PVC (size) (material)			
(6) pump 1/2 10 (HP) (yield gpm)			
Electric (type power)			
(7) electric log no (yes or no)			
(organization running log)			
(8) how well bottom plugged Sand plug			

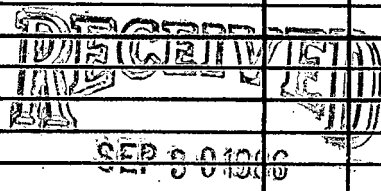


DRILLERS REMARKS:

Report
Department of Natural Resources
Bureau of Land & Water Resources

If well telescopes please sketch and show depths.

GROUND LEVEL

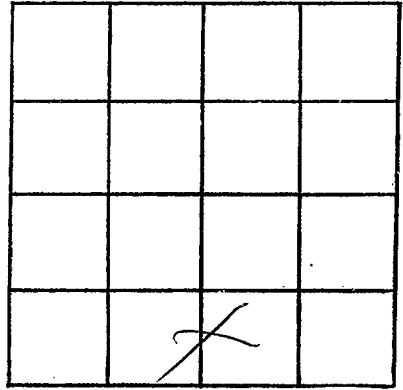

SECTION 18

Please indicate well location X.

ADDITIONAL INFORMATION

If more than one screen,
show locations of each on sketch.