

MISSISSIPPI DEPARTMENT OF NATURAL RESOURCES

Bureau of Land and Water Resources

Southport Mall

P.O. Box 10631

Jackson, Mississippi 39209

WATER WELL DRILLERS LOG

Waltall
A 2068

4-1
date well completed

86 Fitzgerald Well Serv
firm name

Waltall
county well located

LANDOWNER:
Quincy Quinn
R.R. 1, Jayess, ms
(mailing address)

description of formations encountered	from	to
<u>Red clay</u>	<u>0</u>	<u>20</u>
<u>Red sand</u>	<u>20</u>	<u>99</u>
<u>Coarse sand & gravel</u>	<u>99</u>	<u>135</u>

WELL LOCATION:
sec. 7 T 4 N R 10 E
S W
2 miles N of ENON
(distance) (direction) (nearest town)

WELL PURPOSE: Home
(home, irrigation, municipal, industrial)

WELL COMPLETION DATA:

(1) diameter (inches) 4

(2) total depth (feet) 135

(3) static water level (feet) 90 below top of ground.


(4) casing PVC, 125
(material) (depth)
4 If telescope see back.
(size)

(5) screen 16, 125
(length) (depth to top)
4, PVC
(size) (material)

(6) pump 1/2, 10
(HP) (yield gpm)
9hp
(type power)

(7) electric log No
(yes or no)
Shelton
(organization running log)

(8) how well bottom plugged Shelton

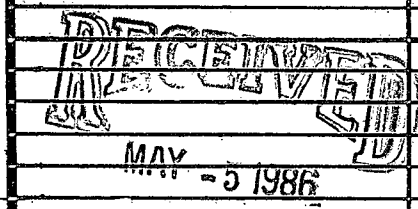


DRILLERS REMARKS:

Department of Natural Resources
Bureau of Land & Water Resources

If well telescopes please sketch and show depths.

GROUND LEVEL

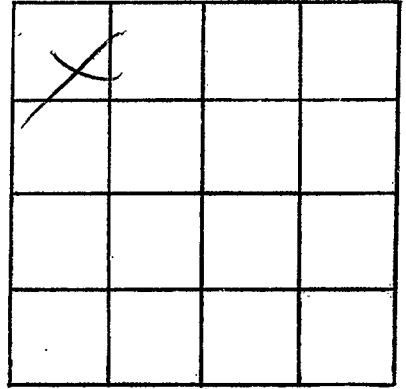

SECTION 7

Please indicate well location X.

ADDITIONAL INFORMATION

If more than one screen,
show locations of each on sketch.