

MISSISSIPPI DEPARTMENT OF NATURAL RESOURCES

Bureau of Land and Water Resources

Southport Mall

P.O. Box 10631

Jackson, Mississippi 39209

WATER WELL DRILLERS LOG

Waltman
A 2008

6-1 1987 Fitzgerald Well Co. wellbore
date well completed firm name county well located


LANDOWNER:	description of formations encountered	from	to
Milton Klein P.R. Feltner SWS. (mailing address)			
WELL LOCATION:			
sec. 32 T 4 N R 10 E S W			
1 1/2 miles S of MAUNINGSS (distance) (direction) (nearest town)			
WELL PURPOSE: Home (home, irrigation, municipal, industrial)			
WELL COMPLETION DATA:			
(1) diameter (inches) 4			
(2) total depth (feet) 123			
(3) static water level (feet) 63 below top of ground.			
(4) casing PVC 113 (material) (depth) 4 (size) if telescope see back.			
(5) screen 10 113 (length) (depth to top) 4 PVC (size) (material)			
(6) pump 1/2 10 (HP) (yield gpm) Elec (type power)			
(7) electric log No (yes or no)			
(organization running log)			
(8) how well bottom plugged Sand fill			

RECEIVED
JUN 15 1987
Department of Natural Resources
Bureau of Land & Water Resources

DRILLERS REMARKS:

If well telescopes please sketch and show depths.

GROUND LEVEL

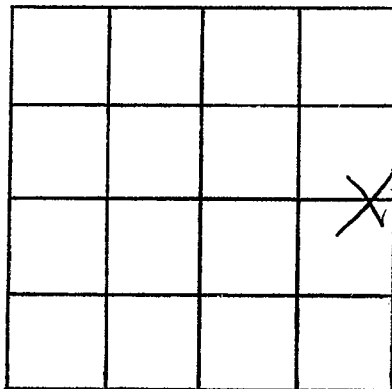

SECTION 32

Please indicate well location X.

ADDITIONAL INFORMATION

If more than one screen,
show locations of each on sketch.