

MISSISSIPPI DEPARTMENT OF NATURAL RESOURCES

Bureau of Land and Water Resources

P.O. Box 10631

Jackson, Mississippi 39209

WATER WELL DRILLERS LOG

COUNTY WELL LOCATED <i>Walsh</i>	
WELL NUMBER <i>A</i>	CODED
DATE WELL COMPLETED <i>Apr 4-90</i>	

PERMIT NUMBER
NAME OF DRILLING FIRM <i>Fitzgerald Well Serv</i>

NAME & MAILING ADDRESS OF LANDOWNER <i>W. F. Rayburn</i> <i>Box 1 Jayes ms.</i>		
WELL LOCATION: SEC <u>5</u> TOWNSHIP <u>4</u> N RANGE <u>10</u> E W		
DISTANCE <u>2</u> Miles	DIRECTION <u>NE</u>	NEAREST TOWN <u>ENOH</u>
OTHER LANDMARK		
WELL PURPOSE: Home, Irrigation, Municipal, Industrial, Fish Pond, etc. <i>Home</i>		

PUMP DATA		
PUMP TYPE (Circle One): Submersible Turbine, Jet, Flowing Well, Other (Describe) _____		
POWER TYPE (Circle One): Electric Tractor, Diesel, Gasoline, Butane, Other (Describe) _____ H/P _____		
Pump Capacity (GPM) <u>10</u>	No. of Stages <u>9</u>	Setting Depth <u>85</u> FT.
PUMP TEST Well yielded <u>25</u> GPM with a drawdown of <u>2</u> ft. after <u>2</u> hours of pumping		

WELL DATA		
Well Depth <u>108</u>	Casing Diameter (In.) <u>4</u>	Casing Length (Ft.) <u>90</u>
Type of Casing <i>N/C</i>	Hole Depth <u>108</u>	Depth to Static Water Level <u>54</u>
TYPE OF COMPLETION: (Circle One or More): Gravel Paacked Underreamed, Telescoped, Natural Development, Open Hole, Other (Describe) _____		
Top of Lap Pipe or Reduction in Casing FEET <input type="checkbox"/> IF TELESCOPED OR MORE THAN ONE SCREEN: USE BACK PAGE		

LOG DATA	
TYPE OF LOG RUN (Circle One): Electric, Gamma Ray, Density, Sonic, No Log Run , Neutron, Other (Describe) _____	
Name of Organization Running Log	

SCREEN DATA		
Diameter - Inches <u>4</u>	Length - Feet <u>10</u>	Slot Size - Inches <u>.014</u>
Screen Type <i>N/C</i>		Depth to Bottom - Feet <u>108</u>


GEOLOGIC DATA (Office Use Only)			
Surface Elev.	Geologic Unit	Unit Thickness	Depth to Top
Subs. SWL	Date	Analysis	Aquifer Test
Driller's Remarks			

DESCRIPTION OF FORMATIONS ENCOUNTERED	FROM	TO	FORMATIONS (Continued)	FROM	TO
<i>Red Clay</i>	<i>0</i>	<i>20</i>	<div style="border: 2px solid black; padding: 5px; display: inline-block;"> RECEIVED MAY 11 1990 </div> Department of Natural Resources Bureau of Land & Water Resources		
<i>Red Sand</i>	<i>20</i>	<i>80</i>			
<i>Reverse Sand & gravel</i>	<i>80</i>	<i>108</i>			

IF MORE SPACE IS NEEDED, USE BACK

If well telescopes please sketch and show depths.

GROUND LEVEL

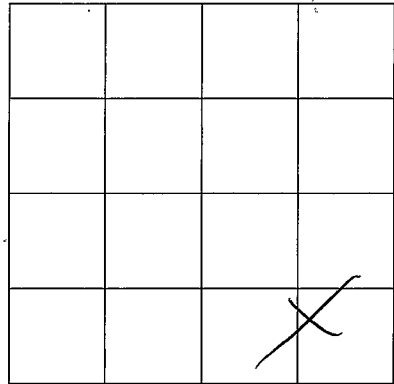

SECTION 5

Please indicate well location X.

ADDITIONAL INFORMATION

If more than one screen,
show location of each on sketch.