

**MISSISSIPPI DEPARTMENT OF ENVIRONMENTAL QUALITY**

Office of Land and Water Resources

P. O. Box 10631  
Jackson, MS 39289-0631  
**WATER WELL DRILLERS LOG**

COUNTY WELL LOCATED <u>WALTON</u>	
WELL NUMBER <b>A</b>	CODED
DATE WELL COMPLETED <u>August 4 93</u>	

PERMIT NUMBER
NAME OF DRILLING FIRM <u>F. F. GERALD Well Serv</u>

NAME & MAILING ADDRESS OF LANDOWNER <u>HARVEY TULLOS</u> <u>RR. JAYESS MS</u>		
WELL LOCATION: SEC	TOWNSHIP	RANGE
<u>29</u>	<u>4</u> <sup>N</sup> <sub>S</sub>	<u>10</u> <sup>E</sup> <sub>W</sub>
DISTANCE	DIRECTION	NEAREST TOWN
<u>1</u> Miles	<u>S</u>	of <u>Elbert</u>
OTHER LANDMARK		
WELL PURPOSE: Home, Irrigation, Municipal, Industrial, Fish Pond, etc. <u>Home</u>		

PUMP DATA		
PUMP TYPE (Circle One): <u>Submersible</u> , Turbine, Jet, Flowing Well, Other (Describe) _____		
POWER TYPE (Circle One): <u>Electric</u> , Tractor, Diesel, Gasoline, Butane, Other (Describe) _____ H/P <u>1/2</u>		
Pump Capacity (GPM) <u>10</u>	No. of Stages <u>8</u>	Setting Depth <u>70</u> FT.
PUMP TEST		
Well yielded <u>25</u> GPM with a drawdown of <u>2</u> ft. after <u>2</u> hours of pumping		

WELL DATA		
Well Depth <u>100</u>	Casing Diameter (In.) <u>4</u>	Casing Length (Ft.) <u>90</u>
Type of Casing <u>PVC</u>	Hole Depth <u>100</u>	Depth to Static Water Level <u>36</u>
TYPE OF COMPLETION: (Circle One or More): <u>Gravel Packed</u> , Underreamed, Telescoped, Natural Development, Open Hole, Other		

LOG DATA	
TYPE OF LOG RUN (Circle One): Electric, Gamma Ray, Density, Sonic, Neutron, Other (Describe) _____	
Name of Organization Running Log <u>No Log Run</u>	

WELL GROUTED TO A DEPTH OF <u>10</u> FEET
Type Grout (circle one): Cement, Bentonite, <u>or Mix</u>

GEOLOGIC DATA (Office Use Only)			
Surface Elev.	Geologic Unit	Unit Thickness	Depth to Top
Subs. SWL	Date	Analysis	Aquifer Test

SCREEN DATA		
Diameter - Inches <u>4</u>	Length - Feet <u>10</u>	Slot Size - Inches <u>0.014</u>
Screen Type <u>PVC</u>	Depth to Bottom - Feet <u>100</u>	


Driller's Remarks

DESCRIPTION OF FORMATIONS ENCOUNTERED	FROM	TO	FORMATIONS (Continued)	FROM	TO
<u>Red Clay</u>	<u>0</u>	<u>20</u>	<b>RECEIVED</b> <b>OCT 18 1993</b> Dept. of Environmental Quality Office of Land & Water Resources		
<u>Red Sand</u>	<u>20</u>	<u>87</u>			
<u>Coarse Sand &amp; Gravel</u>	<u>87</u>	<u>100</u>			

IF MORE SPACE IS NEEDED, USE BACK

If well telescopes please sketch and show depths.

GROUND LEVEL

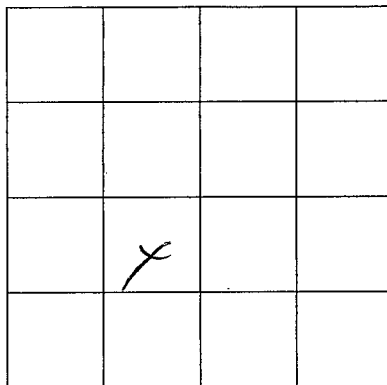

SECTION 29

Please indicate well location X.

ADDITIONAL INFORMATION

If more than one screen,  
show location of each on sketch.