

**MISSISSIPPI DEPARTMENT OF ENVIRONMENTAL QUALITY**

Office of Land and Water Resources

P. O. Box 10631  
Jackson, MS 39289-0631  
**WATER WELL DRILLERS LOG**

COUNTY WELL LOCATED <i>Walworth</i>	
WELL NUMBER <i>A</i>	CODED
DATE WELL COMPLETED <i>2001 Aug 11 94</i>	

PERMIT NUMBER
NAME OF DRILLING FIRM <i>K. F. GERRARD Well Serv</i>

NAME & MAILING ADDRESS OF LANDOWNER <i>Rolando VanDien wright</i>			
<i>RR. Jayess MS</i>			
WELL LOCATION, SEC	TOWNSHIP	RANGE	
<i>6</i>	<i>4</i>	<i>N 10 E</i>	
DISTANCE	DIRECTION	NEAREST TOWN	
<i>3</i> Miles	<i>H</i>	<i>Elmton</i>	
OTHER LANDMARK			
WELL PURPOSE: Home, Irrigation, Municipal, Industrial, Fish Pond, etc. <i>Poultry House</i>			

<b>PUMP DATA</b>			
PUMP TYPE (Circle One): <input checked="" type="checkbox"/> Submersible, Turbine, Jet, Flowing Well, Other (Describe) _____			
POWER TYPE (Circle One): <input checked="" type="checkbox"/> Electric, Tractor, Diesel, Gasoline, Butane, Other (Describe) _____ H/P <i>2</i>			
Pump Capacity (GPM) <i>35</i>	No. of Stages <i>14</i>	Setting Depth <i>130</i>	FT.
PUMP TEST			
Well yielded <i>50</i> GPM with a drawdown of <i>2</i> ft. after <i>2</i> hours of pumping			

<b>WELL DATA</b>		
Well Depth <i>152</i>	Casing Diameter (In.) <i>4</i>	Casing Length (Ft.) <i>142</i>
Type of Casing <i>PVC</i>	Hole Depth <i>152</i>	Depth to Static Water Level <i>89</i>
TYPE OF COMPLETION: (Circle One or More): <input checked="" type="checkbox"/> Gravel Packed, <input type="checkbox"/> Underreamed, <input type="checkbox"/> Telescoped, <input type="checkbox"/> Natural Development, <input type="checkbox"/> Open Hole, <input type="checkbox"/> Other (Describe) _____		

<b>LOG DATA</b>	
TYPE OF LOG RUN (Circle One): <input checked="" type="checkbox"/> No Log Run, <input type="checkbox"/> Electric, <input type="checkbox"/> Gamma Ray, <input type="checkbox"/> Density, <input type="checkbox"/> Sonic, <input type="checkbox"/> Neutron, Other (Describe) _____	
Name of Organization Running Log	

WELL GROUTED TO A DEPTH OF <i>60</i> FEET
Type Grout (circle one): Cement, Bentonite, <input checked="" type="checkbox"/> Mix

<b>GEOLOGIC DATA (Office Use Only)</b>			
Surface Elev.	Geologic Unit	Unit Thickness	Depth to Top
Subs. SWL	Date	Analysis	Aquifer Test

<b>SCREEN DATA</b>		
Diameter - Inches <i>4</i>	Length - Feet <i>20</i>	Slot Size - Inches <i>10/12</i>
Screen Type <i>PVC</i>	Depth to Bottom - Feet <i>152</i>	


Driller's Remarks	
Top of Lap Pipe or Reduction in Casing <b>FEET</b> IF TELESCOPED OR MORE THAN ONE SCREEN: USE BACK PAGE	

DESCRIPTION OF FORMATIONS ENCOUNTERED	FROM	TO
<i>Red Clay</i>	<i>0</i>	<i>20</i>
<i>Red Sand</i>	<i>20</i>	<i>127</i>
<i>Coarse Sand &amp; gravel</i>	<i>127</i>	<i>152</i>

FORMATIONS (Continued)	FROM	TO
<b>RECEIVED</b>		
<b>OCT 14 1994</b>		
Dept. of Environmental Quality Office of Land & Water Resources		
IF MORE SPACE IS NEEDED, USE BACK		

If well telescopes please sketch and show depths.

GROUND LEVEL

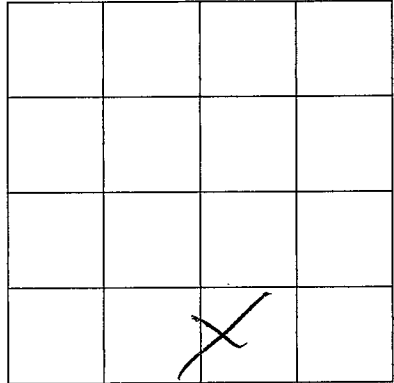

SECTION 6

Please indicate well location X.

ADDITIONAL INFORMATION

If more than one screen,  
show location of each on sketch.