

**MISSISSIPPI
BOARD OF WATER COMMISSIONERS**
416 North State Street
Jackson, Mississippi 39201

WATER WELL DRILLERS LOG

Walthall
B
3-67

3/21 1967 Andys Drilling Co. Walthall
date well completed firm name county well located

LANDOWNER: Deale Swols
Pt. 3 Jaysess, Miss.

(mailing address)

WELL LOCATION:
sec. 28 T. 3 N. R. 14 E
3 miles S.E. of Sweetwater
(distance) (direction) (nearest town)


WELL PURPOSE: Home
(home, irrigation, municipal, industrial)

WELL COMPLETION DATA:

- (1) diameter (inches) 4"
- (2) total depth (feet) 135'
- (3) static water level (feet) 90' below top of ground.
- (4) casing P.V.C. 129'
(material) (depth)
4"
(size) If telescope see back.
- (5) screen 6' 129'
(length) (depth to top)
4" P.V.C.
(size) (material)
- (6) pump 1/2 Subm. 12 gal.
(HP) (yield gpm)
220
(type power)
- (7) electric log No
(yes or no)

(organization running log)
- (8) how well bottom plugged Back
Wash Valve

description of formations encountered	from	to
<u>Red Clay</u>	<u>0'</u>	<u>46'</u>
<u>gravel</u>	<u>40'</u>	<u>45'</u>
<u>Red Chalk</u>	<u>45'</u>	<u>90'</u>
<u>Sand</u>	<u>90'</u>	<u>110'</u>
<u>Coarse sand / Red gravel</u>	<u>110'</u>	<u>135'</u>

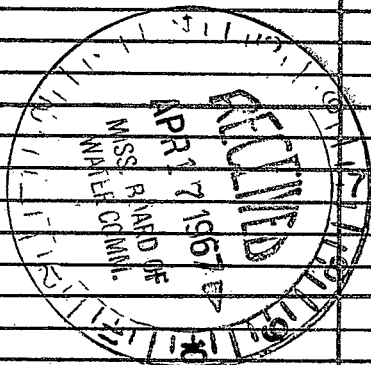

DRILLERS REMARKS:

If well telescopes please sketch and show depths.

GROUND LEVEL

X			

SECTION 28

Please indicate well location X.

ADDITIONAL INFORMATION

If more than one screen, show locations of each on sketch.