

Walthall
B
4-67

MISSISSIPPI
BOARD OF WATER COMMISSIONERS
416 North State Street
Jackson, Mississippi 39201

WATER WELL DRILLERS LOG

476 date well completed 1967 Ardis Drilling firm name Walthall county well located

LANDOWNER: S. E. Boyd
Rt. 1 Jayess,
Miss.
(mailing address)


| description of formations encountered | from | to |
|---------------------------------------|------------|-------------|
| <u>Red Clay</u> | <u>0'</u> | <u>20'</u> |
| <u>Chalk</u> | <u>20'</u> | <u>50'</u> |
| <u>Sand</u> | <u>50'</u> | <u>90'</u> |
| <u>Coarse Sand</u> | <u>90'</u> | <u>100'</u> |

WELL LOCATION:
sec. 6 T. 4 N R. 10 E
2 miles n.w. of Sociedade
(distance) (direction) (nearest town)

WELL PURPOSE: Home
(home, irrigation, municipal, industrial)


- WELL COMPLETION DATA:
- (1) diameter (inches) 4"
 - (2) total depth (feet) 100'
 - (3) static water level (feet) 50' below top of ground.
 - (4) casing P.V.C. 94'
(material) (depth)
4" if telescope see back.
(size)
 - (5) screen 6" 94'
(length) (depth to top)
4" P.V.C.
(size) (material)
 - (6) pump 3 12 gal.
(HP) (yield gpm)
2
(type power)
 - (7) electric log NO
(yes or no)
(organization running log)
 - (8) how well bottom plugged Back
Wash Valve

DRILLERS REMARKS:
No power to lot yet

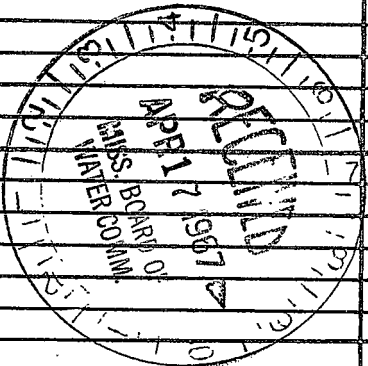

If well telescopes please sketch and show depths.

GROUND LEVEL

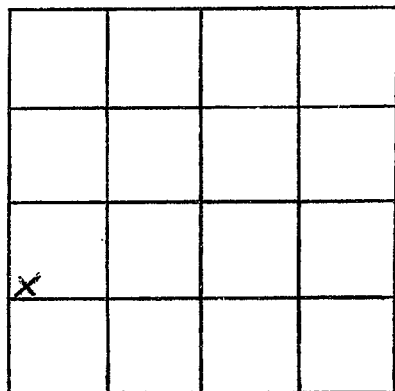

SECTION 6

Please indicate well location X.

ADDITIONAL INFORMATION

If more than one screen,
show locations of each on sketch.