

WALTHALL

B3

6-1-71

MISSISSIPPI BOARD OF WATER COMMISSIONERS

416 North State Street

Jackson, Mississippi 39201

CODED

WATER WELL DRILLERS LOG

6-1 date well completed

1971 *Felgus Well Ltd* firm name

*walthall* county well located

LANDOWNER:

*C. E. Bond*

description of formations encountered

from

to

*B. R. Magnum*  
(mailing address)

*Red clay*

*0 20*

*Red sand*

*20 80*

*Red gravel*

*80 120*

*Red shell*

*120 150*

*Coarse sand*

*150 180*

WELL LOCATION:

sec *11* T *4* N R *11* E  
S W

*5* miles *E* of *Spartanburg*  
(distance) (direction) (nearest town)

WELL PURPOSE:

(home, irrigation, municipal, industrial)

WELL COMPLETION DATA:

- (1) diameter (inches) *4*
- (2) total depth (feet) *180*
- (3) static water level (feet) *120* below above top of ground.

- (4) casing *plastic* (material), *172* (depth), *4* (size) if telescope see back.

- (5) screen *8* (length), *172* (depth to top), *4* (size), *plastic* (material)

- (6) pump *3/4* (HP), *12* (yield gpm), *Elco* (type power)

- (7) electric log *no* (yes or no)

(organization running log)

- (8) how well bottom-plugged *wooden*

CODED


JUL 14 1971

DRILLERS REMARKS:

MISS. BD. OF WATER COM.

If well telescopes please sketch and show depths.

GROUND LEVEL

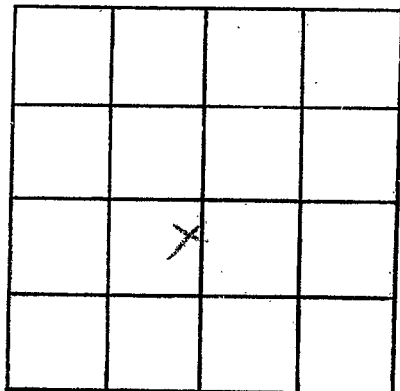

SECTION 21

Please indicate well location X.

ADDITIONAL INFORMATION

If more than one screen,  
show locations of each on sketch.