

B 4

6-1-66

WATER WELL DRILLERS LOG

CODED

Date: 6/1, 1966, Driller: T. B. Andrews County Waltham

(Name)

(1) Owner of Land: Coddie Terrell
(Name)

Tipton Miss.
(Address)

(2) Location: 1/4, 1/4, Sec. 29 T4 R11,

4 miles S of Spartanville
(distance) (direction) (Nearest Town)

(3) Topography: Hilly
(Hilly) (Flat) (Level)

(4) Purpose of Well: Domestic
(Domestic Irrigation
Municipal, Industrial, Other)

Description & Color of Materials
Sand, Clay, Red Clay, Shell, etc.

Thick-
ness
Feet

Depth
Feet

0' to 25'
Red Clay

25' to 70'
Sand

70' to 80'
Sand & gravel

Information upon completion of well:

(1) Diameter 4 inches.

(2) Total Depth 80 feet.

(3) Water Level 50 feet below top of ground.

(4) Cased to 80', Size 4"

(5) Screen: Size 4", Length 6"

(6) Were any formations sealed against pollution?

yes, no.


If YES depth of formation _____

Why _____

Drillers Remarks:

Plastic well

CODED

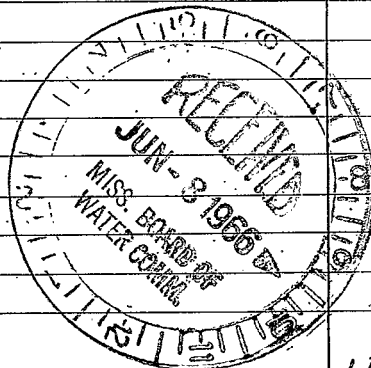

(Use Back Side)

15

Well No.

