

13600
12-66

MISSISSIPPI BOARD OF WATER COMMISSIONERS

CODED

WATER WELL DRILLERS LOG

CODED

Date: 12/7, 1966, Driller: T. B. Andrews County Walsh
(When well drilled) (Name) (Where well is located)

(1) Owner of Land: James Tydes
(Name)
Rt. 3 Joyess, Miss.
(Address)

(2) Location: NW 1/4, NW 1/4, Sec. 11 T4 R1E
3 miles E. of Spartanville
(distance) (direction) (Nearest Town)

(3) Topography: Hilly
(Hilly) (Flat) (Level)

(4) Purpose of Well: Domestic
(Domestic Irrigation
Municipal, Industrial, Other)

Description & Color of Materials Sand, Clay, Red Clay, Shell, etc.	Thick- ness Feet	Depth Feet
Red Clay	60'	60'
gravel	20'	80'
Chalk	20'	100'
Red gravel	10'	110'
Chalk	15'	125'
Sand / red gravel	15'	140'

Information upon completion of well:

(1) Diameter 4 inches.

(2) Total Depth 140 feet.

(3) Water Level 100' feet below top of ground.

(4) Cased to 140', Size 4"

(5) Screen: Size 4", Length 6'

(6) Were any formations sealed against pollution?
_____ yes, no.

CODED


If YES depth of formation _____
Why _____

Drillers Remarks: 4" plastic

Yield in gpm: 10 g.p.m.

Size pump: 3/4 hp Submersible

Type power: (what do I put here)

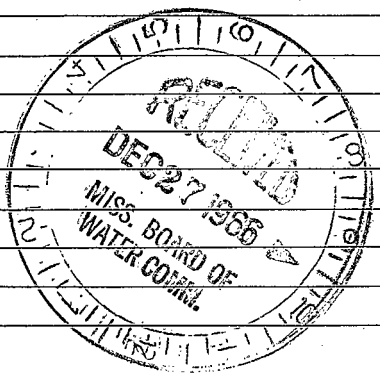

53

