

Walthall

B7

CODED

12-66

MISSISSIPPI BOARD OF WATER COMMISSIONERS

WATER WELL DRILLERS LOG

Date: 12/12, 1966, Driller: T.B. Andrews County: Walthall

(When well drilled)

(Name)

(Where well is located)

- (1) Owner of Land: Dale Evans (Name)  
Rt. 3 Jayess, Miss (Address)
- (2) Location: NW 1/4, NW 1/4, Sec. 15 T4 R11,  
4 1/2 miles S.E. of Sardinville (distance) (direction) (Nearest Town)
- (3) Topography: Hilly (Hilly) (Flat) (Level)
- (4) Purpose of Well: Domestic (Domestic Irrigation Municipal, Industrial, Other)

Description & Color of Materials Sand, Clay, Red Clay, Shell, etc.	Thick- ness Feet	Depth Feet
Red Clay	40'	40'
Sand	45'	85'
Sand / red gravel	21'	106'


Information upon completion of well:

- (1) Diameter 4 inches.
- (2) Total Depth 106 feet.
- (3) Water Level 91 feet below top of ground.
- (4) Cased to 106', Size 4"
- (5) Screen: Size 4", Length 6'
- (6) Were any formations sealed against pollution?  
no.  no.

CODED

If YES depth of formation Why

Drillers Remarks: Plastic  
Yield in gpm:   
Size pump: Did Not install pump  
Type power:                 

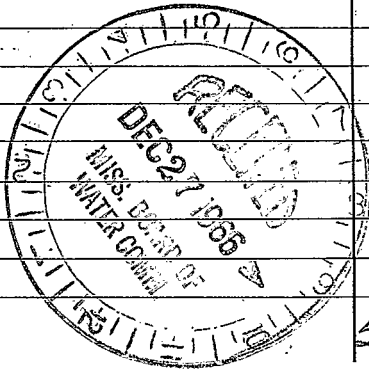

54

