

Walthall
 B8 CODED
 1-68

MISSISSIPPI
 BOARD OF WATER COMMISSIONERS
 416 North State Street
 Jackson, Mississippi 39201

WATER WELL DRILLERS LOG

Jan 23 1968 Styguent Well Service Walthall
 date well completed firm name county well located

LANDOWNER:
Charles Brewer
RR Tylectown, Miss.
 (mailing address)


description of formations encountered	from	to
Red clay	0	15
Red sand	15	55
Coarse sand + gravel	55	60
Red sand	60	80
Coarse sand + gravel	80	98

WELL LOCATION:
 sec. 33T 4N, R 11E
14 miles N of Tylectown
 (distance) (direction) (nearest town)

WELL PURPOSE: Home
 (home, irrigation, municipal, industrial)

- WELL COMPLETION DATA:
- (1) diameter (inches) 4
 - (2) total depth (feet) 98
 - (3) static water level (feet) 55 below above top of ground.
 - (4) casing Plastic 92'
 (material) (depth)
4" if telescope see back.
 (size)
 - (5) screen 6' 92'
 (length) (depth to top)
4" plastic
 (size) (material)
 - (6) pump ? ?
 (HP) (yield gpm)
Electric
 (type power)
 - (7) electric log No
 (yes or no)
 (organization running log)
 - (8) how well bottom plugged beadings


CODED

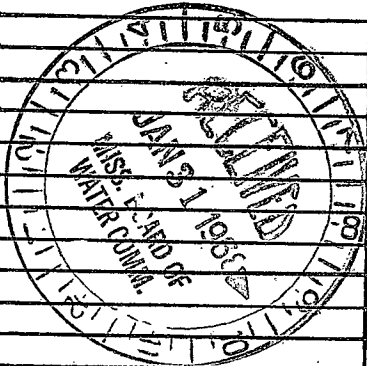

DRILLERS REMARKS:

If well telescopes please sketch and show depths.

GROUND LEVEL

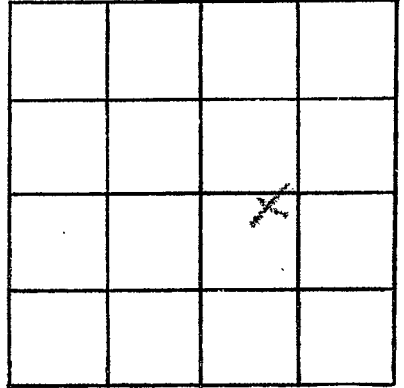

SECTION 33

Please indicate well location X.

ADDITIONAL INFORMATION

If more than one screen, show locations of each on sketch.