

Walthall
B9
3-67

CODED

MISSISSIPPI
BOARD OF WATER COMMISSIONERS
416 North State Street
Jackson, Mississippi 39201

WATER WELL DRILLERS LOG

3/21 1967 date well completed
Caulig Drilling Co. firm name
Walthall county well located

LANDOWNER: Doyle Saults
P.O. 3 Jayess
Miss.
(mailing address)

WELL LOCATION:
sec. 28 T. 4. N R. 11 E
8 miles S.E. of Sikeeville
(distance) (direction) (nearest town)


WELL PURPOSE: Home
(home, irrigation, municipal, industrial)

WELL COMPLETION DATA:

- (1) diameter (inches) 4"
- (2) total depth (feet) 135'
- (3) static water level (feet) 90' below top of ground.
- (4) casing P.V.C. 129' (material) (depth)
4" (size) if telescope see back.
- (5) screen 6' 129' (length) (depth to top)
4" (size) P.V.C. (material)
- (6) pump 1/2 12 (HP) (yield gpm)
- R.E.A. 220 (type power)
- (7) electric log No (yes or no)
- (organization running log)
- (8) how well bottom plugged Back Wash Valve

description of formations encountered	from	to
Red Clay	0'	46'
Gravel	46'	45'
Red Chalk	45'	90'
Sand	90'	110'
Coarse Sand (fine gravel)	110'	135'


CODED

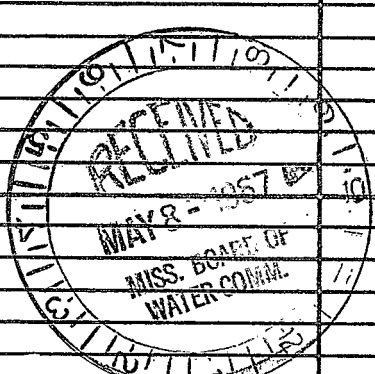

DRILLERS REMARKS:
Submersible Pump

If well telescopes please sketch and show depths.

GROUND LEVEL

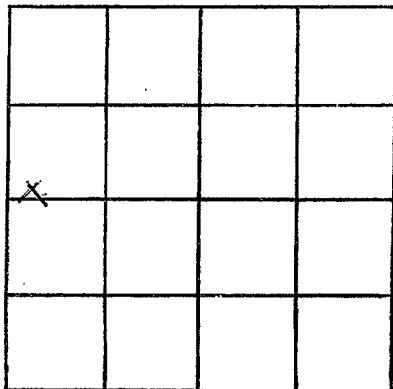

SECTION 28

Please indicate well location X.

ADDITIONAL INFORMATION

If more than one screen,
show locations of each on sketch.