

Walthall

B 10

4-67

MISSISSIPPI
 BOARD OF WATER COMMISSIONERS
 416 North State Street
 Jackson, Mississippi 39201

WATER WELL DRILLERS LOG

4/6
date well completed

67 Andy's Drilling Co.
firm name

Walthall
county well located

LANDOWNER: S.E. Boyd

ct. 1 Jayess

Miss.

(mailing address)

WELL LOCATION:

sec. 6 T. 4 N. R. 14 E.
5 7
2 miles N.W. of Setonville
 (distance) (direction) (nearest town)

WELL PURPOSE: Home
 (home, irrigation, municipal, industrial)

WELL COMPLETION DATA:

- (1) diameter (inches) 4"
- (2) total depth (feet) 100'
- (3) static water level (feet) 50 below
 top of ground. above
- (4) casing P.V.C., 94'
 (material) (depth)
4"
 (size) if telescope see back.
- (5) screen 6", 94"
 (length) (depth to top)
4", P.V.C.
 (size) (material)
- (6) pump _____ (HP) _____ (yield gpm)
REP. 220
 (type power)
- (7) electric log No
 (yes or no)

 (organization running log)
- (8) how well bottom plugged Back
Wash Valve

description of formations encountered

from

to

Red Clay

0' 20'

Chalk

20' 50'


Sand

50' 90'

Coarse Sand

90' 100'

CODED

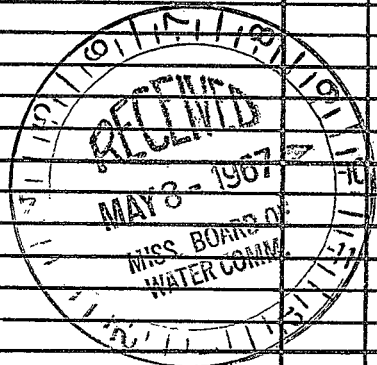

DRILLERS REMARKS:

Did not install pump



If well telescopes please
sketch and show depths.

GROUND LEVEL

		X	

SECTION 6

Please indicate well location X.

ADDITIONAL INFORMATION

If more than one screen,
show locations of each on sketch.