

**MISSISSIPPI
BOARD OF WATER COMMISSIONERS**
416 North State Street
Jackson, Mississippi 39201

WATER WELL DRILLERS LOG

Walthall
Howe

Walthall
B 11 CODED
5-67

date well completed *5/17/67* 19 *Andy's Drilling Co.* firm name county well located *Howe*

LANDOWNER:
William Beeland
Rt. 1 Yokogo, Miss.
(mailing address)

description of formations encountered	from to	
<i>Red Clay</i>	<i>0'</i>	<i>40'</i>
<i>Sand gravel</i>	<i>40'</i>	<i>60'</i>
<i>CLAY</i>	<i>60'</i>	<i>90'</i>
<i>Coarse Sand gravel</i>	<i>90'</i>	<i>110'</i>

WELL LOCATION:
sec. *34* T *5* S R *11* E
3 miles *S.W.* of *Darben*
(distance) (direction) (nearest town)

WELL PURPOSE: *Home*
(home, irrigation, municipal, industrial)

WELL COMPLETION DATA:

(1) diameter (inches) *4"*

(2) total depth (feet) *110"*

(3) static water level (feet) *60'* below top of ground.

(4) casing *P.V.C.*, *104'*
(material) (depth)
4" If telescope see back.
(size)

(5) screen *6"*, *104'*
(length) (depth to top)
4", *P.V.C.*
(size) (material)


(6) pump *1/2*, *12*
(HP) (yield gpm)

R.E.A. 220
(type power)

(7) electric log *no*
(yes or no)

(organization running log)


(8) how well bottom plugged *Back Wash Valve*

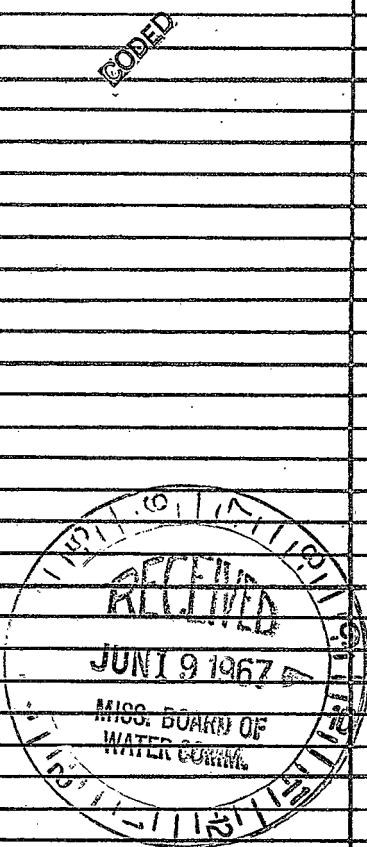

DRILLERS REMARKS:
Submersible pump

If well telescopes please sketch and show depths.

GROUND LEVEL

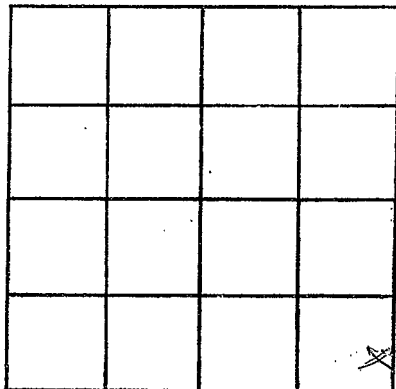

SECTION _____

Please indicate well location X.

ADDITIONAL INFORMATION

If more than one screen,
show locations of each on sketch.