

WALTHALL

B 13

7-67

CODED

MISSISSIPPI  
 BOARD OF WATER COMMISSIONERS  
 416 North State Street  
 Jackson, Mississippi 39201

WATER WELL DRILLERS LOG

7-26

1967

Beegan & Fiel

Walthall

date well completed

firm name

county well located

LANDOWNER: J. C. Bracy

description of formations encountered

from

to

H. I. Hobens, Minn

Clay  
Coarse sand

0 110  
110 158

(mailing address)

WELL LOCATION:

sec. 13 T. 4(N) S. R. 11(E) W.  
10 miles N of Hobens  
(distance) (direction) (nearest town)

WELL PURPOSE: Home  
(home, irrigation, municipal, industrial)

WELL COMPLETION DATA:

(1) diameter (inches) 2"  
(2) total depth (feet) 158'  
(3) static water level (feet) 48' below top of ground.

CODED

(4) casing plastic, 155'  
(material) (depth)

if telescope see back.  
(size)

(5) screen 3', 155'  
(length) (depth to top)  
.010, Stainless Steel  
(size) (material)

(6) pump 1 1/2  
(HP) (yield gpm)  
elec-  
(type power)

(7) electric log no  
(yes or no)

(organization running log)


(8) how well bottom plugged Boob  
wash valve

RECEIVED  
MAY 5 1969  
MISS. BOARD OF  
WATER COMMISSIONERS

DRILLERS REMARKS:

If well telescopes please sketch and show depths.

GROUND LEVEL

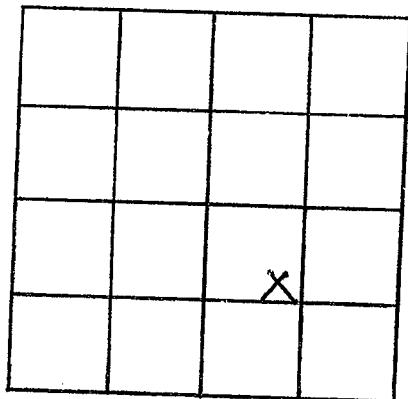

SECTION 13

Please indicate well location X.

ADDITIONAL INFORMATION

If more than one screen, show locations of each on sketch.