

Walthall
B 14
12-68

MISSISSIPPI
BOARD OF WATER COMMISSIONERS
416 North State Street
Jackson, Mississippi 39201

CODED

WATER WELL DRILLERS LOG

Dec. 23 1968 Reeves well drillers Walthall
date well completed firm name county well located

LANDOWNER: J.P. Craft
RFD
Jays
(mailing address)

description of formations encountered	from	to
yellow clay	0	28
Red Sand	28	72
Coarse Sand & fine gravel	72	94

WELL LOCATION:
sec. 1 T. 4 N. R. 11 E
1 1/2 miles W Sartwell
(distance) (direction) (nearest town)

WELL PURPOSE: Home
(home, irrigation, municipal, industrial)

WELL COMPLETION DATA:

(1) diameter (inches) 4 1/4

(2) total depth (feet) 94

(3) static water level (feet) 27 below top of ground.
(above)

(4) casing Plastic ballam
(material) (depth)

 If telescope see back.
(size)

(5) screen 6' 38
(length) (depth to top)
4" Plastic
(size) (material)

(6) pump 1/2 12
(HP) (yield gpm)
Electric
(type power)

(7) electric log NO
(yes or no)

(organization running log)

(8) how well bottom plugged
wooden plug

DRILLERS REMARKS:
old 2" well bad


CODED

DATE: 2-7-1969

MISS. DE. OF WATER CONTROL

If well telescopes please sketch and show depths.

GROUND LEVEL

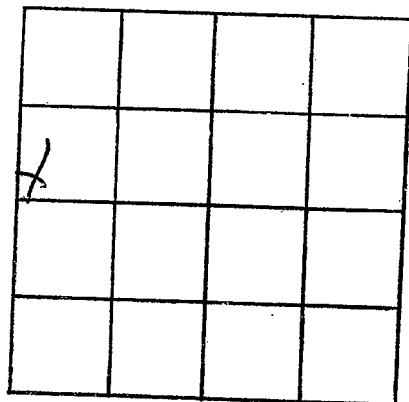

SECTION 7

Please indicate well location X.

ADDITIONAL INFORMATION

If more than one screen,
show locations of each on sketch.