

WALTHALL
 B 15
 7-12-69

MISSISSIPPI
 BOARD OF WATER COMMISSIONERS
 416 North State Street
 Jackson, Mississippi 39201

CODED
 CODED

WATER WELL DRILLERS LOG

July 12 1969 *Reverend Pump Co - Walthall*
 date well completed firm name county well located

LANDOWNER: *McJeherson*
RFD
Jagers
 (mailing address)

WELL LOCATION:
 sec *30* T *4* N R *11* E
1 1/4 miles N of *Tylantown*
 (distance) (direction) (nearest town)

WELL PURPOSE: *Home*
 (home, irrigation, municipal, industrial)

WELL COMPLETION DATA:

- (1) diameter (inches) *4"*
- (2) total depth (feet) *160*
- (3) static water level (feet) *61* below top of ground.
- (4) casing *plastic ballons*
 (material) (depth)
 (size) if telescope see back.
- (5) screen *6'* *154'*
 (length) (depth to top)
4" *plastic*
 (size) (material)
- (6) pump *old unused*
 (HP) (yield gpm)
elect
 (type power)
- (7) electric log *no*
 (yes or no)
 (organization running log)

description of formations encountered	from to	
	feet	feet
<i>Red clay</i>	<i>0</i>	<i>15</i>
<i>Red sandy chert</i>	<i>15</i>	<i>62</i>
<i>Sand & gravel</i>	<i>62</i>	<i>70</i>
<i>Hard chert of</i>		
<i>sandy sand</i>	<i>60</i>	<i>147</i>
<i>small bands</i>	<i>147</i>	<i>160</i>

(8) how well bottom plugged *was drilled*


DRILLERS REMARKS:
old well pump
any

SEP 20 1969

MISS. BD. OF
 WATER COMM.

If well telescopes please
sketch and show depths.

GROUND LEVEL

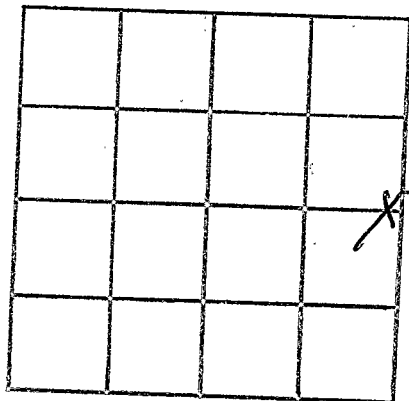

SECTION 30

Please indicate well location X.

ADDITIONAL INFORMATION

If more than one screen,
show locations of each on sketch.