

Walshall
B 20
3-70

MISSISSIPPI
BOARD OF WATER COMMISSIONERS
416 North State Street
Jackson, Mississippi 39201

CODED

WATER WELL DRILLERS LOG

MARCH 1970 E.B. SHERRARD WALSHALL
date well completed firm name county well located

LANDOWNER:	description of formations encountered	from	to
ROLAND TYSON	RED SANDY	0	25'
JAYESS, Miss. (mailing address)	CLAY SAND CLAY STREAKS	25	80'
WELL LOCATION: sec 34 T 4 N R 11 E 11 miles NE of TYLER TOWN (distance) (direction) (nearest town)	SAND WITH GRAVEL PEA GRAVEL SAND VERY COARSE	80	98'
WELL PURPOSE: (home) irrigation, municipal, industrial			
WELL COMPLETION DATA:			
(1) diameter (inches) 3 1/2"			
(2) total depth (feet) 118			
(3) static water level (feet) 45 below top of ground			
(4) casing PL 118' (material) (depth) 4" if telescope see back. (size)			
(5) screen 10' (length) (depth to top) 4" PLASTIC (size) (material)			
(6) pump MAN POWER (HP) (yield gpm) BUCKET (type power)			
(7) electric log (yes or no)			
(organization running log)			
(8) how well bottom plugged B.W.V.			
DRILLERS REMARKS: B.P.M. DEPENDING HOW FAST MAN CAN DRAW			


CODED

ROAD 17 1970

MISS. Bd. of
WATER COMMISSIONERS

If well telescopes please sketch and show depths.

GROUND LEVEL

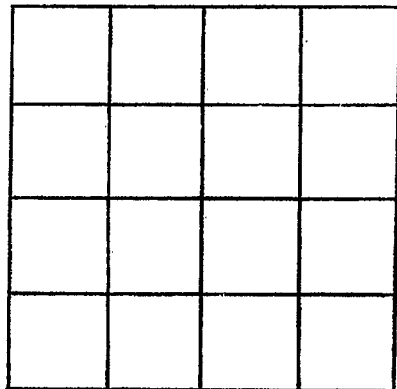

SECTION _____

Please indicate well location X.

ADDITIONAL INFORMATION

If more than one screen, show locations of each on sketch.

PHI